


PLAT OF SURVEY
OF

LOT 1 OF WALWORTH COUNTY CERTIFIED SURVEY MAP NO. 1789, FOR LANDS
LOCATED IN THE NW 1/4 OF THE SW 1/4 AND IN THE SW 1/4 OF THE SW 1/4
OF SECTION 23, T. 2 N., R. 18 E. OF THE 4TH P.M., TOWNSHIP OF LYONS,
COUNTY OF WALWORTH, STATE OF WISCONSIN.

FOR: DREMO SCALE 1" = 40' ——— DENOTES LINE NOT TO SCALE

Ø = IRON PIPE STAKE FOUND

BEARING DATUM IS THAT OF RECORDED CSM

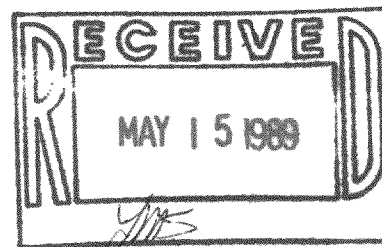

I have surveyed the above-described property,
and the map hereon is a true representation
thereof and shows the size and location of the
property, its exterior boundaries, the location
and dimensions of all visible structures thereon,
fences, apparent easements and roadways and
visible encroachments, if any.

This survey is made for the exclusive use of
the present owners of the property, and also
those who purchase, mortgage, or guarantee
the title thereto, within one year from date
hereof,

Dated at Burlington, this 11th day
of MAY, 1989

John F. Degen
John F. Degen, Land Surveyor S 242
589 N. Pine St. Burlington, WI 53105

