
KOLB LAND CONSULTING, INC.

LAND SURVEYING . SUBDIVIDING . LAND PLANNING

LAKE GENEVA, WISCONSIN 53147

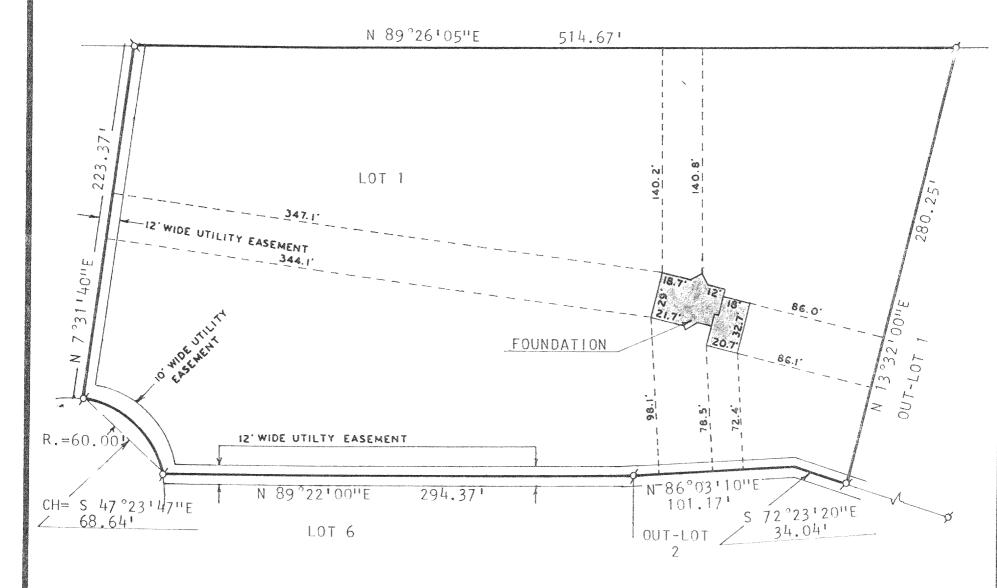

PLAT OF SURVEY OF FOUNDATION LOCATION ON

LOT 1 OF HEATHERIDGE SUBDIVISION LOCATED IN THE SOUTHWEST 1/4 OF SECTION 18, T2N, R18E, TOWN OF LYONS, WALWORTH COUNTY, WISCONSIN.

SCALE: 1"= 60'

LEGEND

Ø- IRON PIPE FOUND

ORDERED BY: NILES MCMASTER 3208 S. ALPINE ROAD

ROCKFORD, IL. 61109-2603

NOTE: BEARINGS ARE ASSUMED AS SHOWN ON RECORDED SUBDIVISION PLAT.



I, HAROLD H. KOLB, DO HEREBY CERTIFY THAT I HAVE SURVEYED THE PROPERTY HEREON DESCRIBED ACCORDING TO THE OFFICIAL RECORDS AND THAT THE PLAT HEREON IS A CORRECT REPRESENTATION OF THE LOT LINES AND PRINCIPAL LINES OF THE FOUNDATION TO THE BEST OF MY KNOWLEDGE AND BELIEF. SURVEY NOT VALID UNLESS SURVEYOR'S SIGNATURE IS IN RED.

HAROLD H. KOLB WISCONSIN REGISTERED LAND SURVEYOR, S- 187 JUNE 6, 1990