

KOLB LAND CONSULTING, INC.
LAND SURVEYING • SUBDIVIDING • LAND PLANNING

LAKE GENEVA, WISCONSIN 53147

N 89°28'20" E 679.13'

CORNER FALLS IN DRAINAGE DITCH

CORNER IN MARSH

LOT 8
6.14 ACRES

12' WIDE UTILITY EASEMENT

SEPTIC
VENT
▲

CORNER IN MARSH

FOUNDATION

CONCRETE PATIO

PROPANE
TANK

WELL

SIDEWALK

GRAVEL
DRIVE

UTILITY BOX


PLAT OF SURVEY OF

LOT 8 OF MEADOW HILL FARMS A SUBDIVISION LOCATED
IN SECTION 32, T 2 N, R 18 E, TOWN OF LYONS,
WALWORTH COUNTY, WISCONSIN.

ORDERED BY: CHARLES H. WISE
11 S 261 DUNHAM
LEMONT, IL 60439

COBBLE CREEK
DRIVE 66' WIDE


R=66'

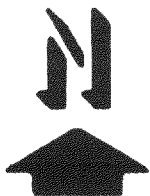

SCALE : 1" = 60'

LEGEND

- ♠ - IRON PIPE FOUND
- ♠ - IRON ROD FOUND

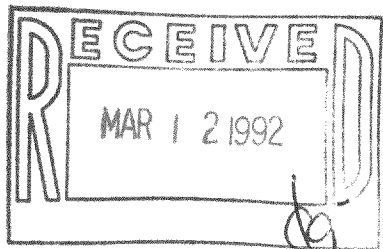

I HEREBY CERTIFY THAT I HAVE SURVEYED THE
ABOVE DESCRIBED PROPERTY AND THAT THE ABOVE
MAP IS A TRUE REPRESENTATION THEREOF AND
SHOWS THE SIZE AND LOCATION OF THE PROPERTY,
ITS EXTERIOR BOUNDARIES, THE LOCATION OF ALL
VISIBLE STRUCTURES AND DIMENSIONS OF ALL
PRINCIPAL BUILDINGS THEREON, BOUNDARY FENCES,
APPARENT EASEMENTS, ROADWAYS AND VISIBLE
ENCROACHMENTS, IF ANY, TO THE BEST OF MY
KNOWLEDGE AND BELIEF.

THIS SURVEY IS MADE FOR THE USE OF THE
PRESENT OWNERS OF THE PROPERTY, AND ALSO
THOSE WHO PURCHASE, MORTGAGE, OR GUARANTEE
THE TITLE THERETO WITHIN ONE (1) YEAR FROM
DATE HEREOF. THIS SURVEY IS NOT VALID UNLESS
THE SURVEYOR'S SIGNATURE IS IN RED.

HAROLD H. KOLB
WISCONSIN REGISTERED LAND SURVEYOR, S-187
DATE JANUARY 6, 1992