


LOT 9, ZACCARD'S SPRING VALLEY ESTATES, A PLAT OF RECORD, LOCATED IN SECTIONS 11 AND 14, T. 2 N., R. 18 E. OF THE 4TH P.M., TOWNSHIP OF LYONS, COUNTY OF WALWORTH, COUNTY OF WALWORTH.

E = ELEVATION FOR SOIL SYSTEM.

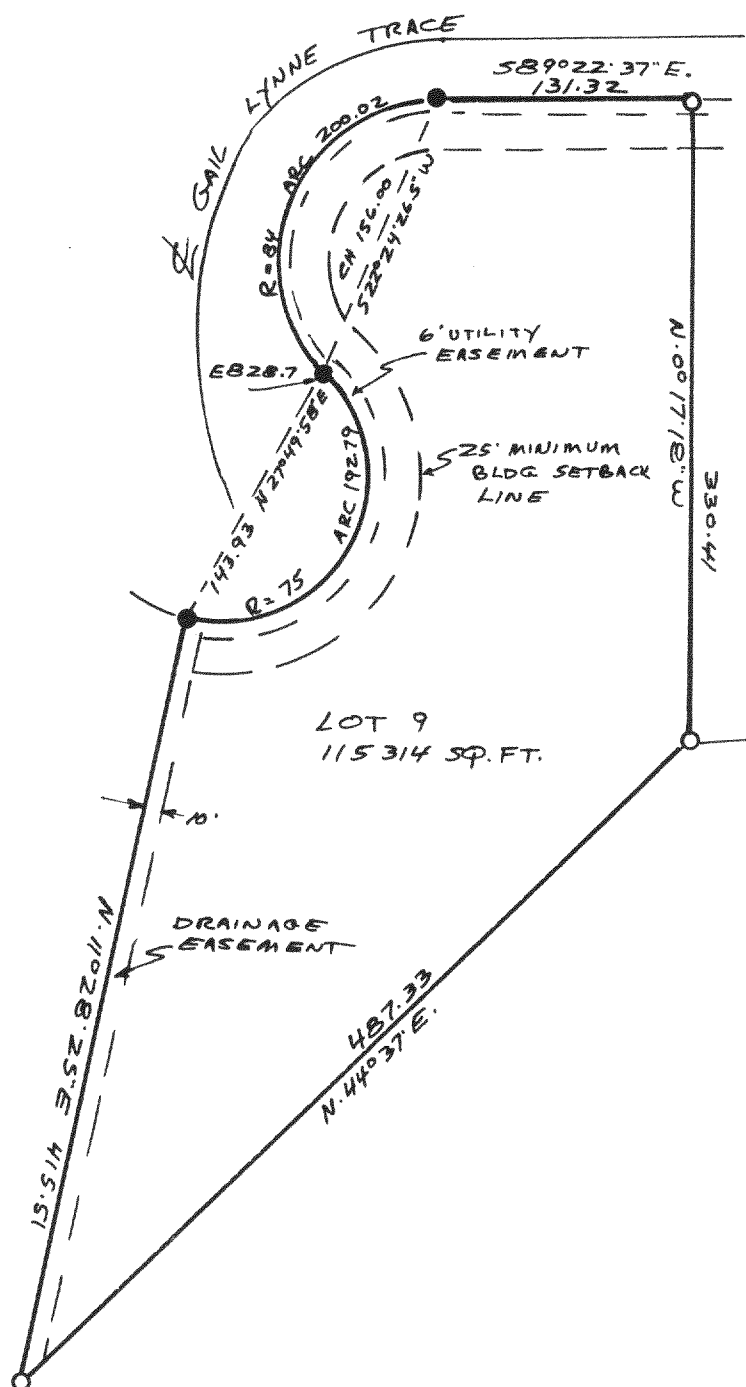

John F. Degen, Land Surveyor S 242
589 N. Pine St. Burlington, WI 53105