



Plat of Survey

SITUATED ON LYONDALE COURT, IN THE TOWN OF LYONS, WISCONSIN.
LOT 2 IN HEGEMAN'S SUBDIVISION, BEING A SUBDIVISION OF A PART OF THE NE 1/4 OF THE SW 1/4 AND PART OF THE SE 1/4 OF THE SW 1/4 OF SECTION 10, T 2 N, R 18 E, IN THE TOWN OF LYONS, RALWORTH COUNTY, WISCONSIN.

SEPTEMBER 4, 1994

MICHAEL AND JANICE BARTELSON

SURVEY NO. 156035-S

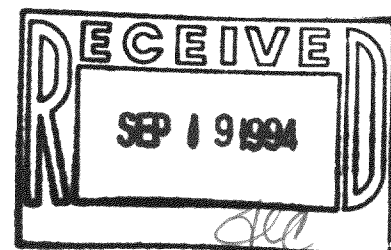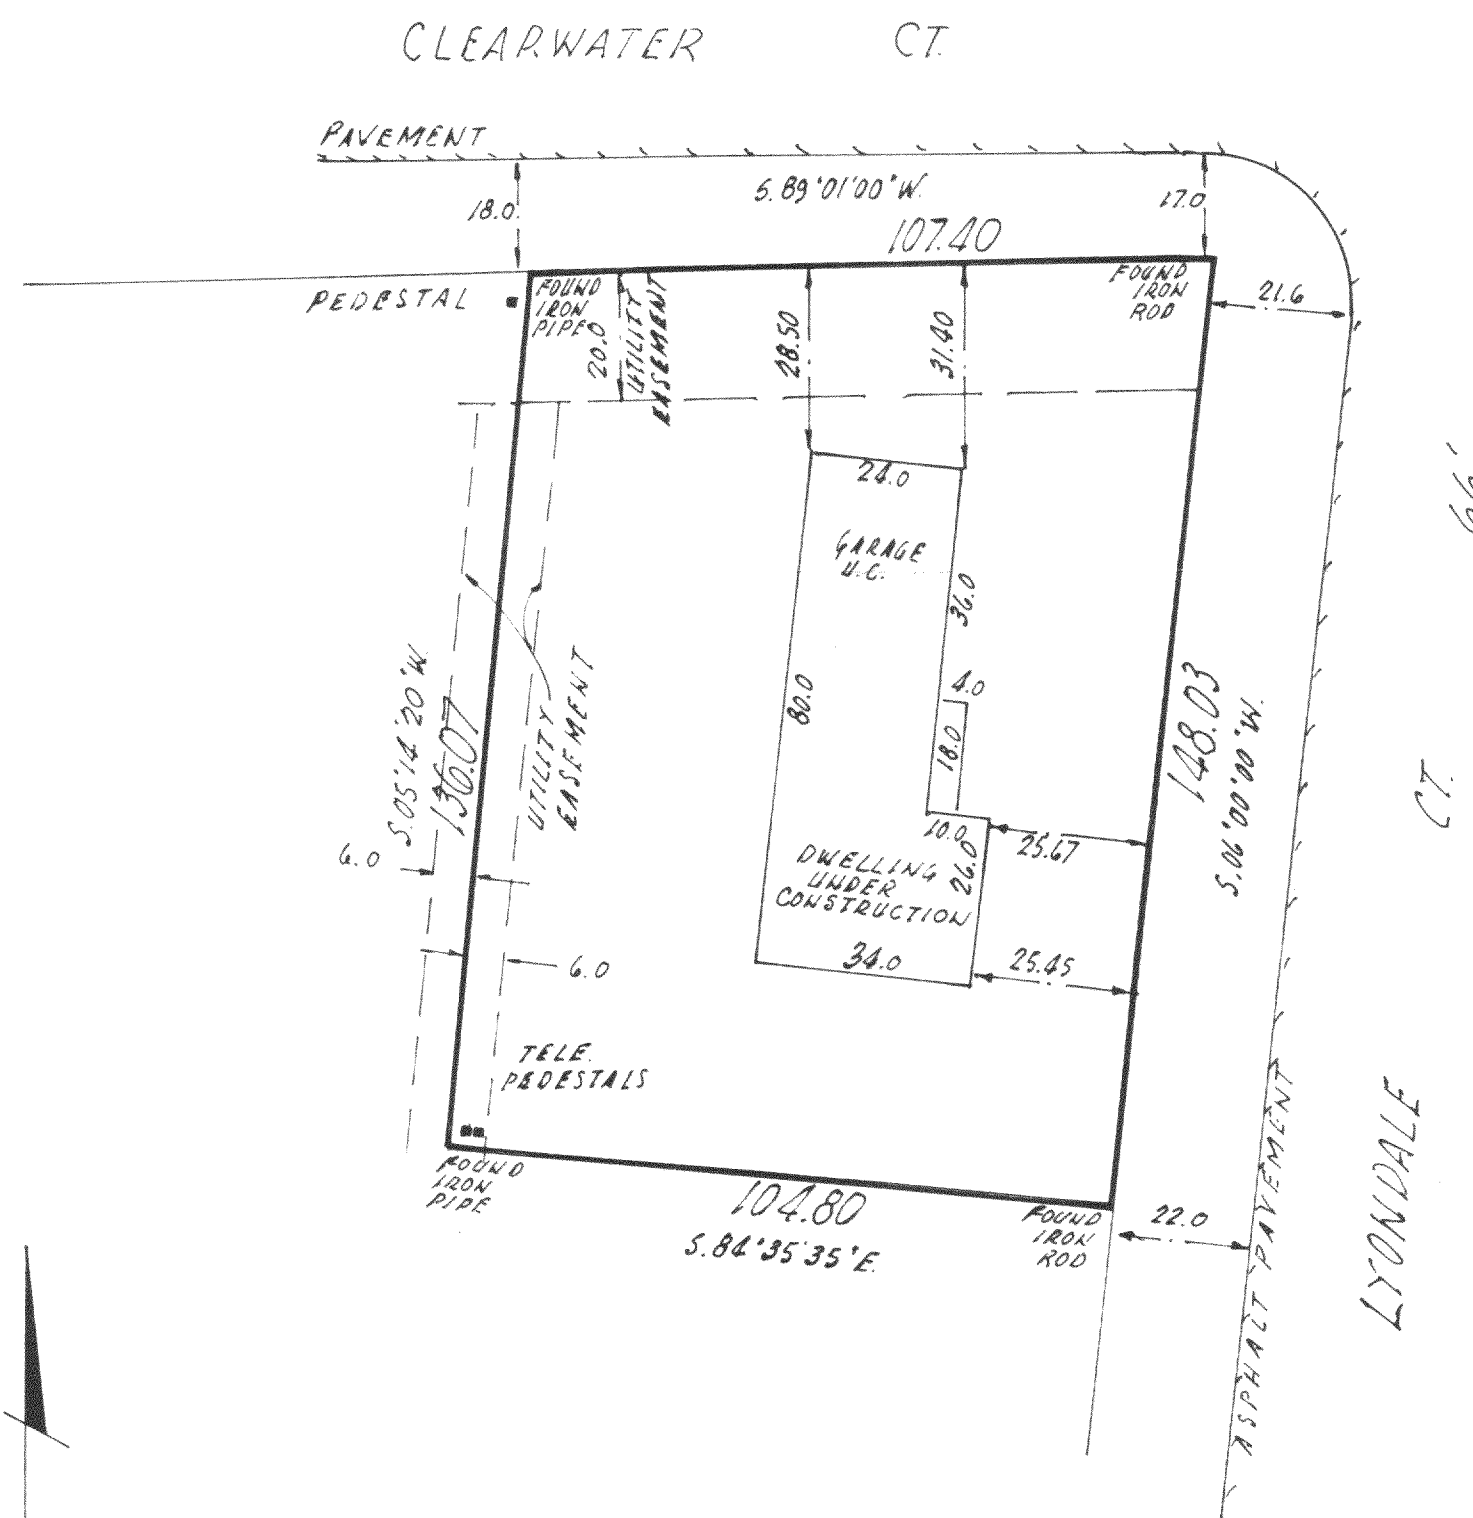


SCALE - 1" = 30'-00"

NHE-2

218-784

I Certify that I have surveyed the above described property (Property), and the above map is a true representation thereof and shows the size and location of the Property, its exterior boundaries, the location and dimensions of all visible structures thereon, boundary fences, apparent easements and roadways and visible encroachments, if any.

 This survey is made for the exclusive use of the present owners of the Property, and also those who purchase, mortgage, or guarantee the title thereto, within one (1) year from date hereof.



national survey & engineering

4125 north 124th street • brookfield, wisconsin, 53008-0444
phone 414 / 781-1000

