

ABERNATHY and ASSOCIATES

Kenneth B. Abernathy Jr.

Wisconsin Registered Land Surveyor

S-1594

W4056 Bray Road
Elkhorn, Wisconsin 53121
Phone (414) 723-4260 (office)
(414) 723-4813 (residence)

PLAT OF SURVEY

Lot 2 of Certified Survey Map Number 2161,
located in part of the Northwest 1/4 of the
Northeast 1/4 and part of the Southwest 1/4 of the
Northeast 1/4 of Section 34, Town 2 North,
Range 18 East, Town of Lyons, Walworth County,
Wisconsin.

Lot 3

Lot 2
5 Acres ±

Lot 1

South Road

66' Wide

N 0°22'38" W

379.80'

33.00'

379.80'

33.00'

DRIVEWAY
ACCESS

15'

15'

40'

40'

S 89°48'13" E 607.01'

574.01'

393.4'

574.01'

N 89°48'13" W 607.01'

See
Detail

(UNDER CONSTRUCTION)
Existing
Dwelling
Detail

Scale: 1 inch = 10 feet

Legend


- FOUND IRON PIPE
- FOUND IRON ROD
- FOUND BRASS CAPPED MONUMENT
- FOUND CONCRETE MONUMENT
- CHISEL CUT IN CONCRETE
- SET IRON ROD, 24" LONG, WEIGHING 1.5 LBS., LINEAL FT. 3/4" DIA.
- SET IRON ROD, 30" LONG, WEIGHING 4.5 LBS., LINEAL FT. 1 1/16" DIA.
- RECORDED AS DIMENSION
- EXISTING FENCE

SCALE: 1"=30 FEET

I hereby certify that the above described property has been surveyed
by me or under my direction and that the above map is a true
representation thereof and shows the size and location of the property,
its exterior boundaries, the location of all visible structures and
dimensions of all principal buildings thereon, boundary fences, apparent
easements, roadways and visible encroachments, if any.
This survey is made for the use of the present owners of the property
and also those who purchase mortgage or guarantee the title thereto
within one year from date hereof.

TERRY W. SCHILLING, WISCONSIN
REGISTERED LAND SURVEYOR S-2193

Date: November 9, 1994 Job No. 1994-917AB

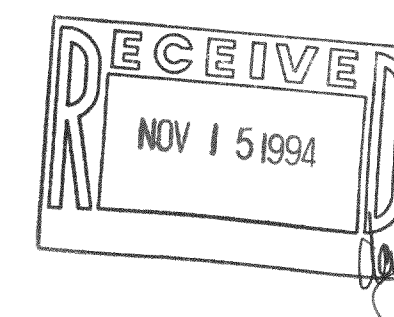

Terry W. Schilling