


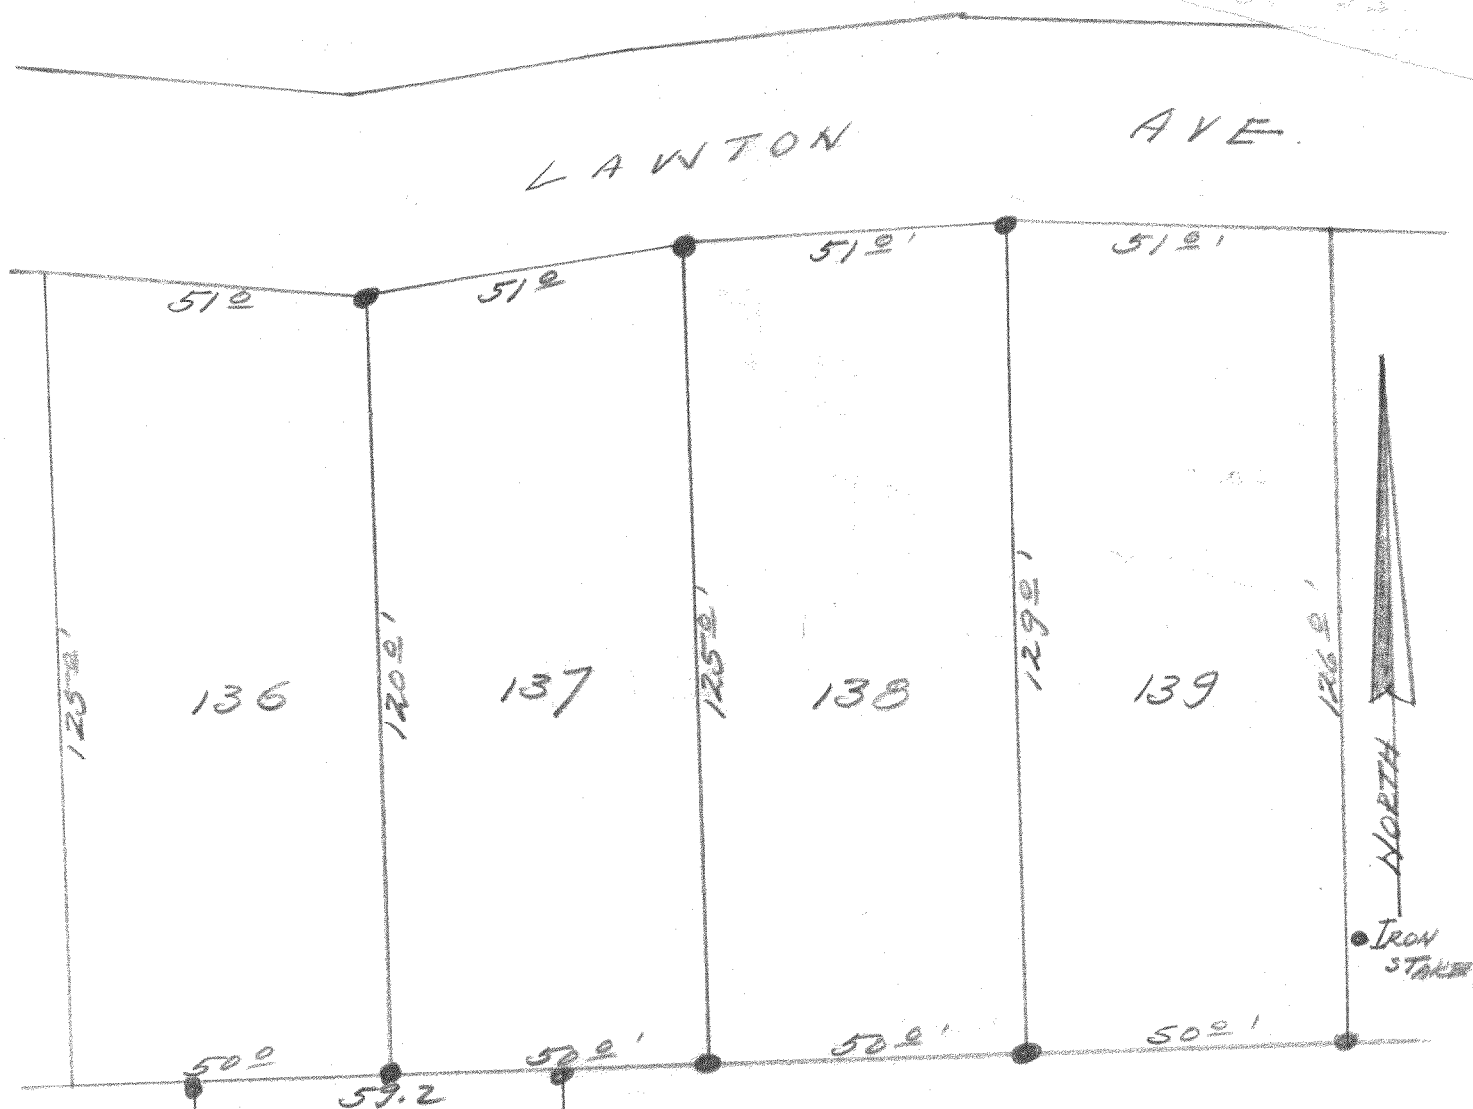

DESCRIPTION: Lots 137 and 138 Lake Geneva Golf Hills Subdivision of a portion of Section 31, Town 2 north, Range 18, east of the 4th Principal Meridian.

CERTIFICATE: I, hereby certify that I have on this the 2nd day of April 1953, surveyed the above described property according to the official record, and that no encroachments exist.

SIGNED AND SEALED ON THIS THE 2ND DAY OF APRIL 1953.

*Joseph M. Biagi*  
Joseph M. Biagi. Professional Engineer.  
Elkhorn Wisconsin.

218-8113