


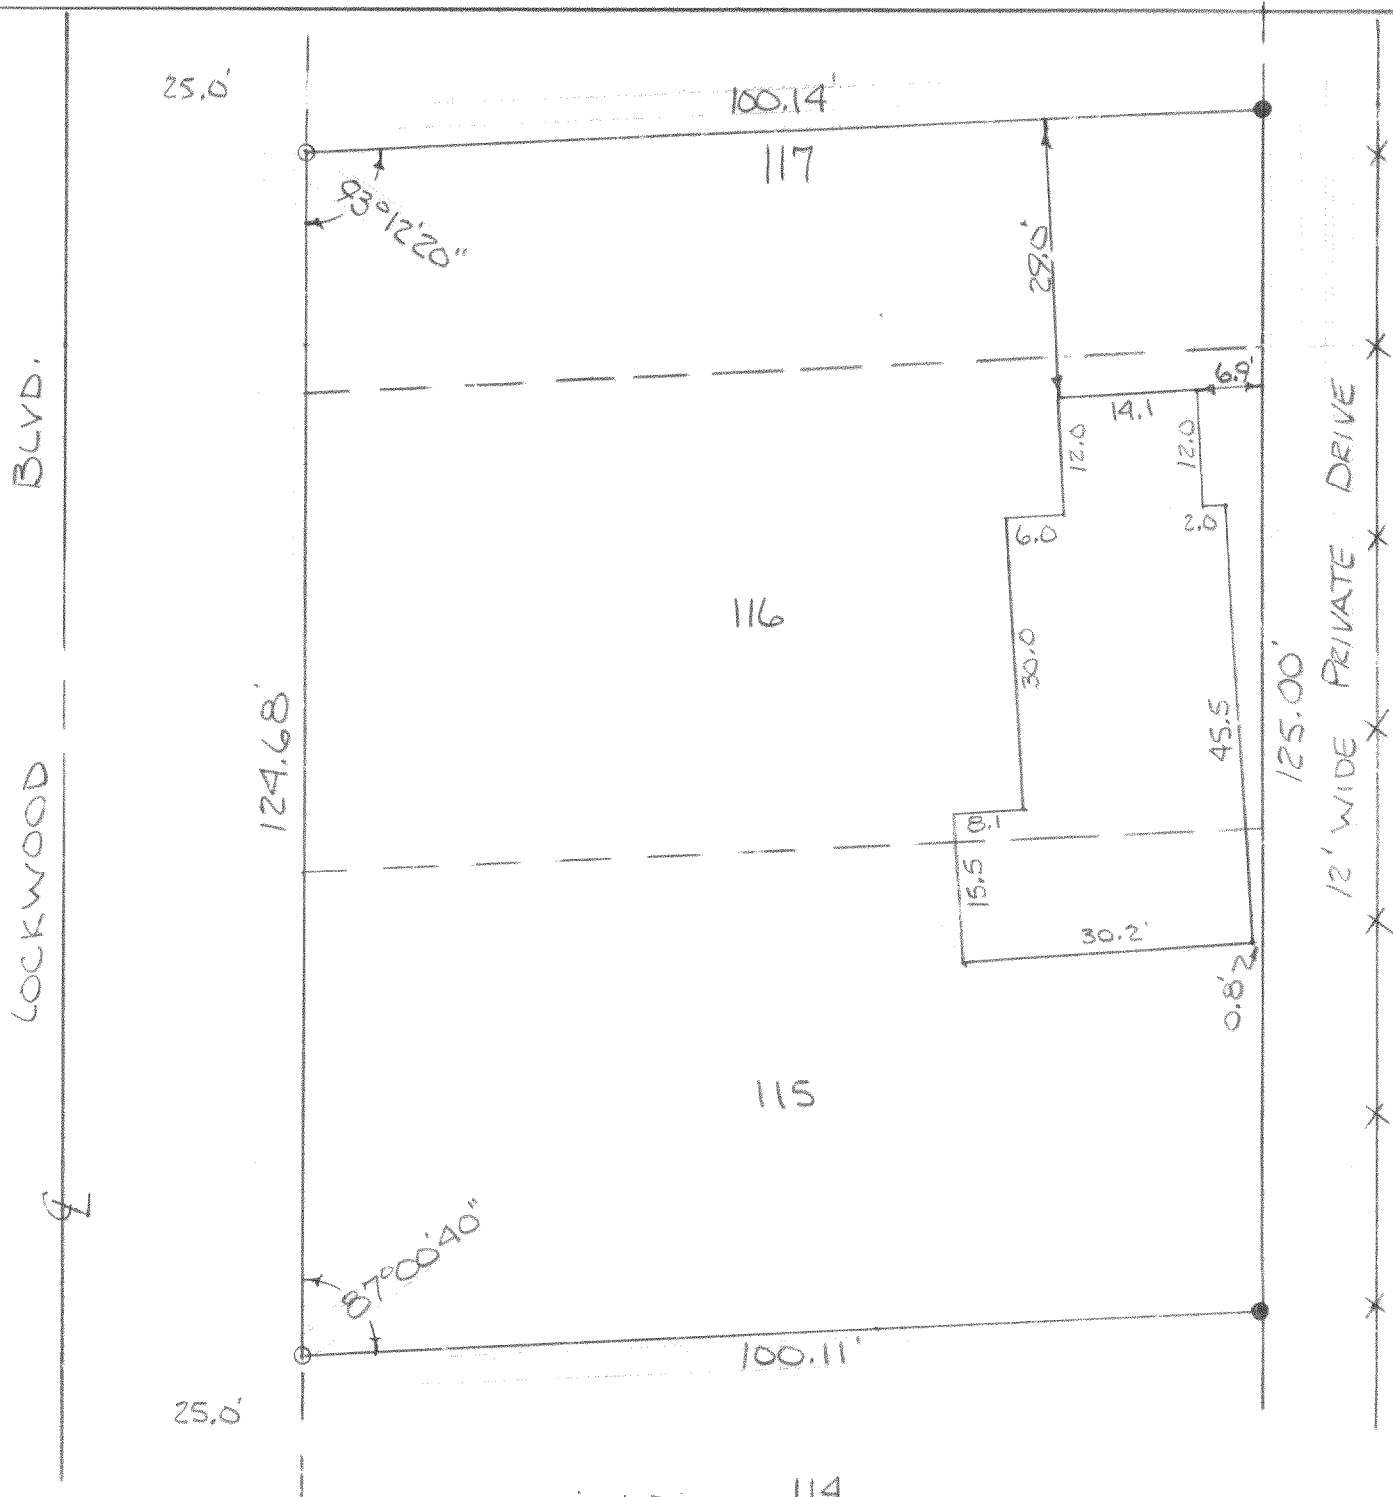

○ - INDICATES IRON PIPE 114

● - INDICATES  $\frac{3}{4}$ " IRON ROD

#### DESCRIPTION:

All of Lots 115 & 116 and the South  $\frac{1}{2}$  of Lot 117 all in Lake Geneva Golf Hills Add.a subdivision located in Section 31, T2N, R18E, Walworth County, Wisconsin.

#### CERTIFICATE:

I, Joseph M. Biagi, surveyor, do hereby certify that I have surveyed the lands hereon described.

#### DATE:

August 13, 1973

Joseph M. Biagi  
Elkhorn, Wisconsin

RLS #12