

PLAT OF SURVEY
OF

LOT 14, ZACCARD'S SPRING VALLEY ESTATES, A PLAT OF RECORD, LOCATED IN SECTIONS
11 & 14, T. 2 N., R. 18 E. OF THE 4TH P.M., TOWNSHIP OF LYONS, COUNTY OF WALWORTH,
STATE OF WISCONSIN.

FOR: HARDESTY

SCALE 1" = 100'

○ = IRON PIPE STAKE

DATE OF FIELD SURVEY 10-18-91
DATE OF PLAT. 3-11-94
RE-SURVEYED 1-3-96

● = SOLID IRON ROD

E = ELEVATION FOR SOIL SYSTEM.

I have surveyed the above-described property,
and the map hereon is a true representation
thereof and shows the size and location of the
property, its exterior boundaries, the location
and dimensions of all visible structures (bldg.,
fences, apparent easements and roads, and
visible encroachments, if any.



This survey is made for the exclusive use of
the present owners of the property, and also
those who purchase, mortgage, or guarantee
the title thereto, within one year from date
hereof.

Dated at Burlington, this 11th day,
of MARCH, 1994

John F. Degen

John F. Degen, Land Surveyor No. 212
(589 N. Pine St. Burlington, WI 53105)

RE-SURVEYED 1-3-96

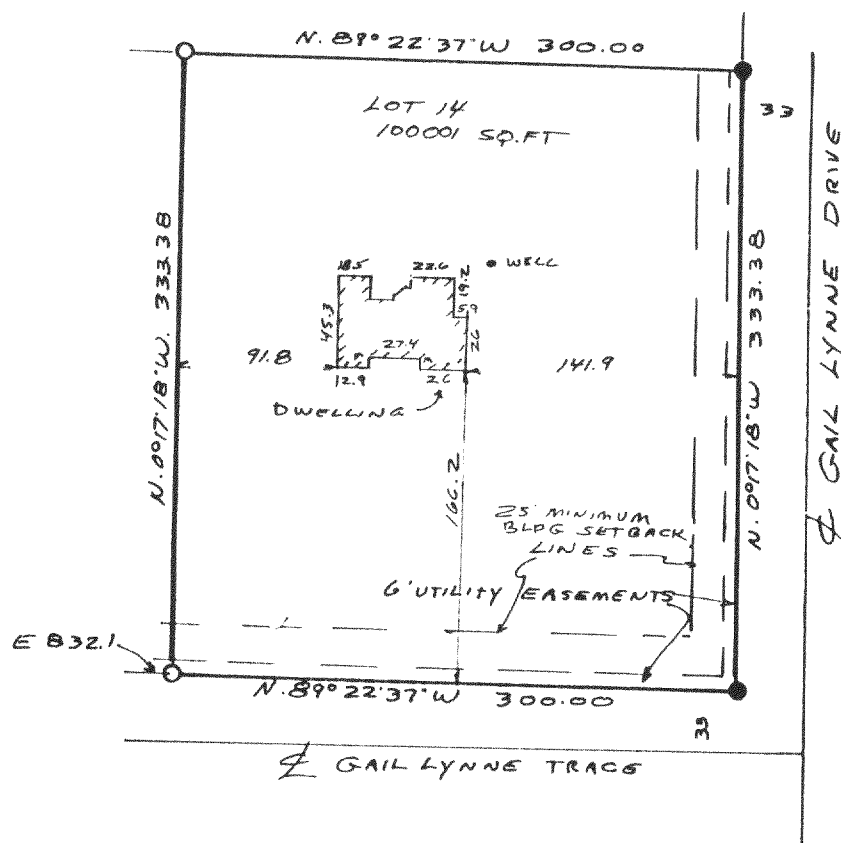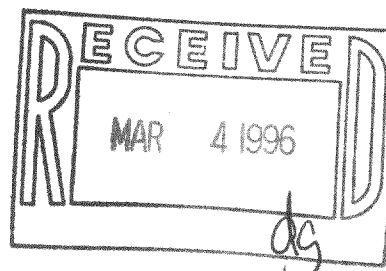

NZA-14

218-887

16-F-2 #54