

PLAT OF SURVEY
OF

LOT 2, WALWORTH COUNTY CSM 2197 FOR LANDS LOCATED IN SECTION 13, T. 2 N., R. 18 E. of THE
4TH P.M., TOWNSHIP OF LYONS, COUNTY OF WALWORTH, STATE OF WISCONSIN.


FOR: FREITAG

SCALE 1" = 100'

σ = IRON PIPE FOUND.

✕ = PIPE SHOWN ON OTHER
SURVEYS, NOT LOCATED
IN THIS SURVEY.

PROPOSED BUILDING STAKED ON SITE WITH SPIKES.

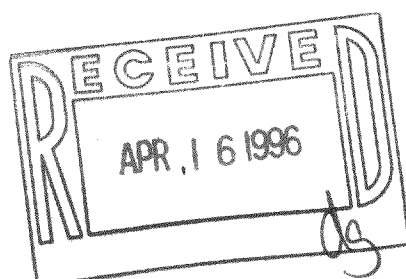


I have surveyed the above-described property,
and the map hereon is a true representation
thereof and shows the size and location of the
property, its exterior boundaries, the location
and dimensions of all visible structures thereon,
fences, apparent easements and roadways and
visible encroachments, if any.

This survey is made for the exclusive use of
the present owners of the property, and also
those who purchase, mortgage, or guarantee
the title thereto, within one year from date
hereof.

Dated at Burlington, this 24th day,
of MARCH 1996

John F. Degen
John F. Degen, Land Surveyor S 242
589 N. Pine St. Burlington, WI 53105

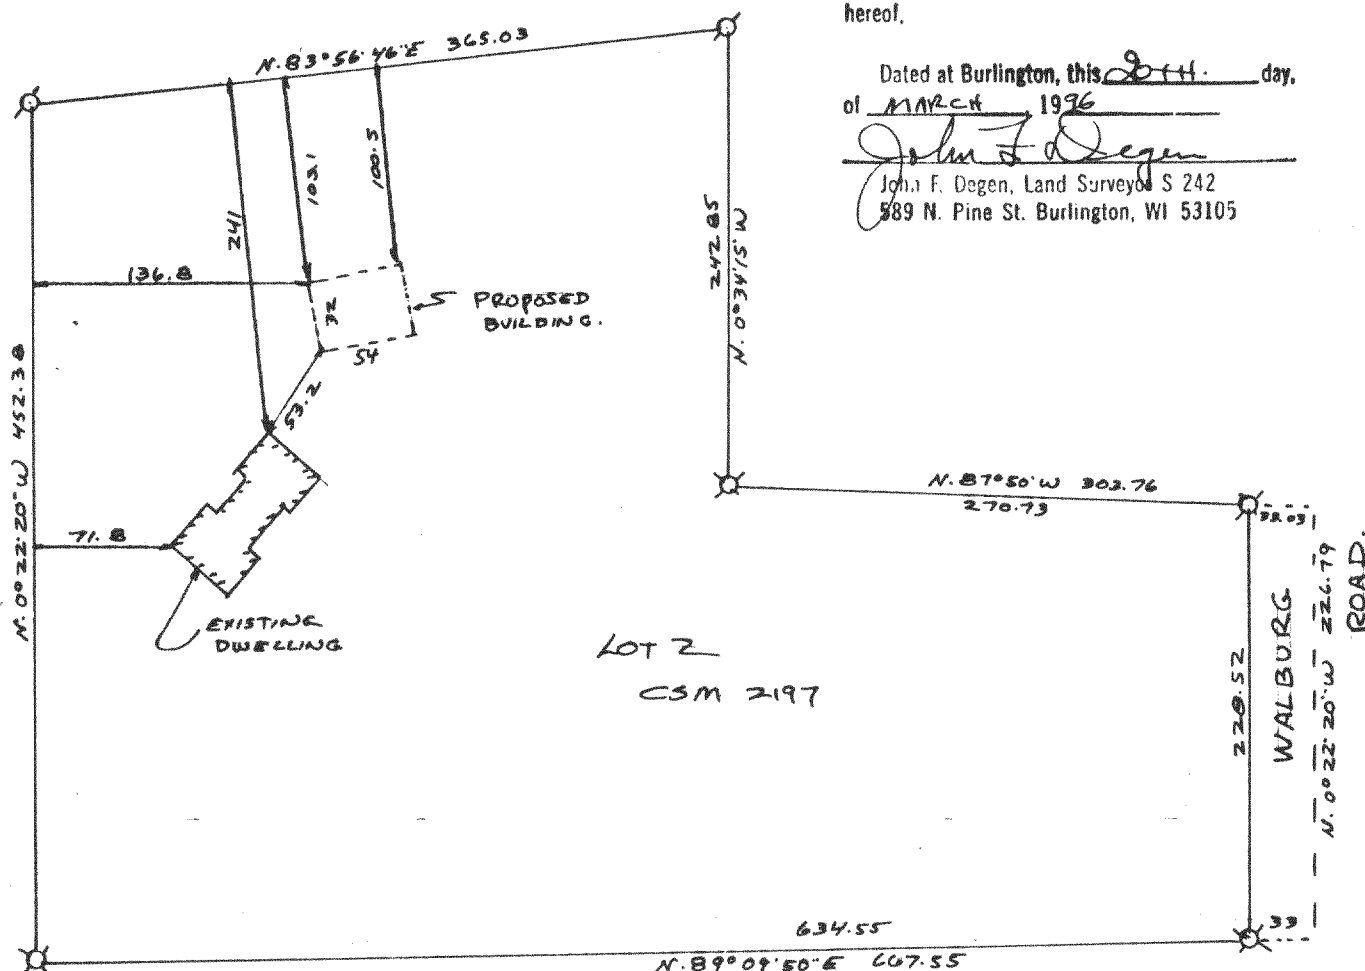

NA-2197-2

218-900

19-A #44

PLAT OF SURVEY
OF

LOT 2, WALWORTH COUNTY CSM 2197 FOR LANDS LOCATED IN SECTION 13, T. 2 N., R. 18 E. of THE
4TH P.M., TOWNSHIP OF LYONS, COUNTY OF WALWORTH, STATE OF WISCONSIN.


FOR: FREITAG

SCALE 1" = 100'

⌢ = IRON PIPE FOUND.

⌢ = PIPE SHOWN ON OTHER
SURVEYS, NOT LOCATED
IN THIS SURVEY.

PROPOSED BUILDING STAKED ON SITE WITH SPIKES.

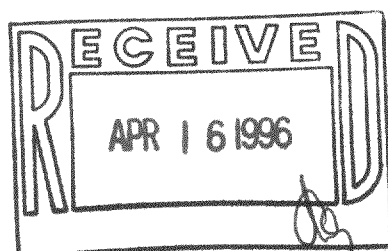

I have surveyed the above-described property,
and the map hereon is a true representation
thereof and shows the size and location of the
property, its exterior boundaries, the location
and dimensions of all visible structures thereon,
fences, apparent easements and roads, and
visible encroachments, if any.

This survey is made for the exclusive use of
the present owners of the property, and also
those who purchase, mortgage, or guarantee
the title thereto, within one year from date
hereof.

Dated at Burlington, this 24th day,
of MARCH, 1996

John F. Degen
John F. Degen, Land Surveyor S 242
589 N. Pine St. Burlington, WI 53105
3-27-96 CORRECTION - PROPOSED
BUILDING SIZE.

