

ABELL  
SURVEYING & MAPPING  
DELAVAN, WISCONSIN 53115  
414-728-6737



SCALE 1"=20'

LEGEND

- Ø -IRON PIPE FOUND
- -IRON PIPE SET
- ( ) -RECORDED AS

NOTE: BEARINGS ARE REFERENCED TO THE  
RECORDED CONDOMINIUM PLAT.

ORDERED BY: BILL LEYDA  
1460 LIBERTY LANE  
BURLINGTON, WI 53105



I, DAVID F. ABELL, DO HEREBY CERTIFY THAT I HAVE SURVEYED THE PROPERTY HEREON  
DESCRIBED ACCORDING TO THE OFFICAL RECORDS AND THAT THE PLAT HEREON IS A  
CORRECT REPRESENTATION OF THE PROPERTY LINES TO THE BEST OF MY KNOWLEDGE AND  
BELIEF.

*David F. Abell*

DAVID F. ABELL  
WISCONSIN REGISTERED LAND SURVEYOR, S-1596

July 2, 1996

DATE JOB NUMBER - 96097  
NOTE: THIS IS NOT A CERTIFIED COPY UNLESS SEALED.

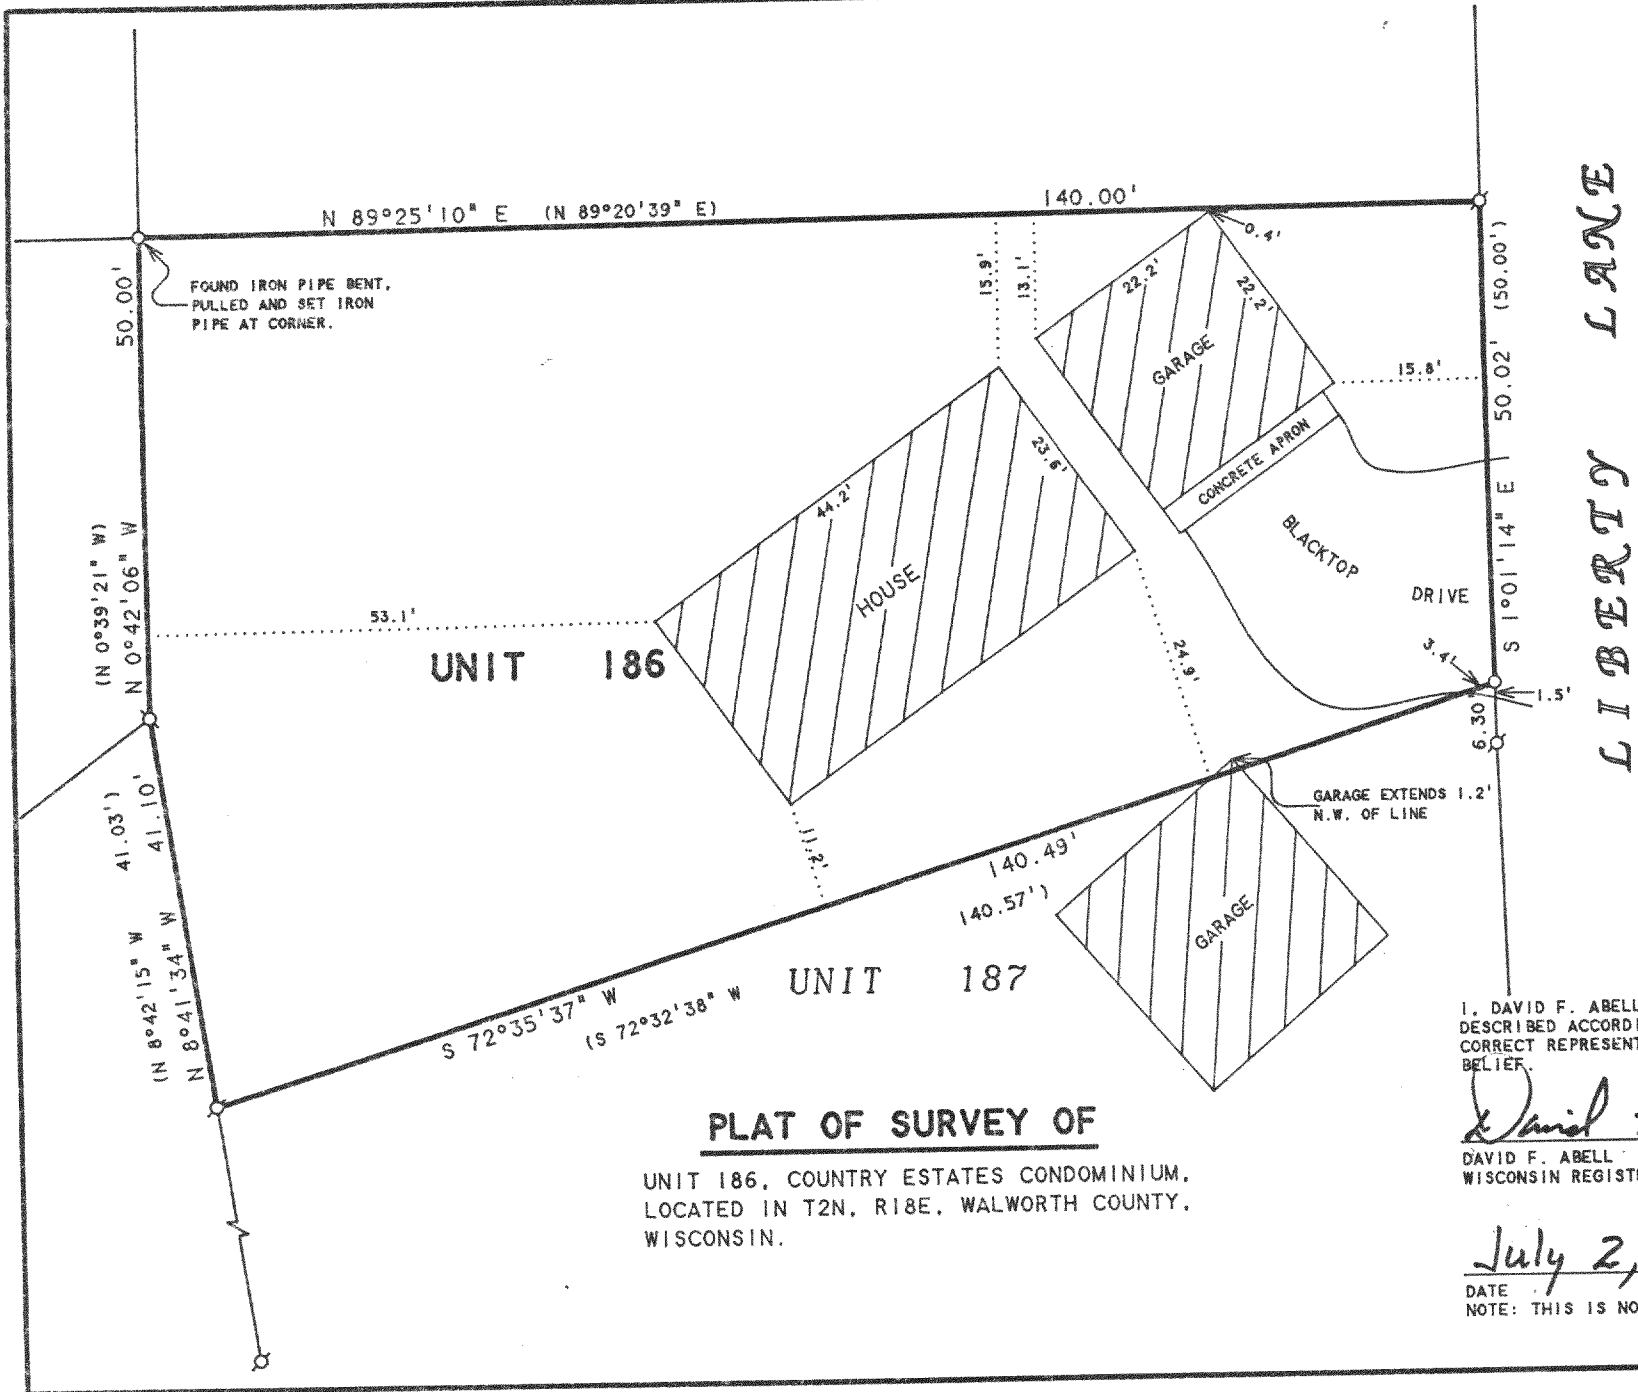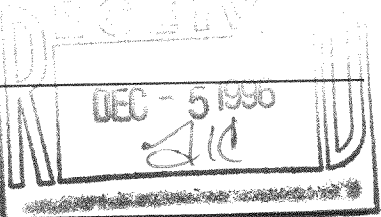

NCS-186

218-928