


PREPARED FOR : RE/MAX GENEVA REALTY, LTD  
 C/O PHYLLIS SAAB  
 101 BROAD ST. SUITE 102  
 LAKE GENEVA WI. 53147

J.K. SURVEYING INC.  
 N3705 WILLOWBEND LANE  
 LAKE GENEVA, WI, 53147  
 262-248-3697

# PLAT OF SURVEY

- OF -

LOT 18 OF GENEVA TERRITORY 1ST ADDITION, A SUBDIVISION LOCATED IN THE SOUTHWEST 1/4 OF SECTION 28, THE SOUTHEAST 1/4 OF SECTION 29, THE NORTHEAST 1/4 OF SECTION 32 AND THE NORTHWEST 1/4 OF SECTION 33, TOWN 2 NORTH, RANGE 18 EAST, TOWNSHIP OF LYONS, WALWORTH COUNTY, WISCONSIN.

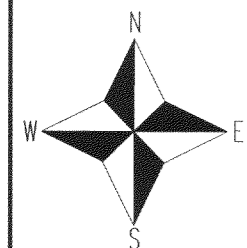


- ( ) = recorded as
- = found iron bar
- = found iron pipe
- = set iron pipe
- = set iron bar

SCALE 1" = 30'

JOB # 05-228

TAX ID # NDA100007


FOUND IRON PIPE  
 ONLINE 0.28'  
 WEST OF CORNER

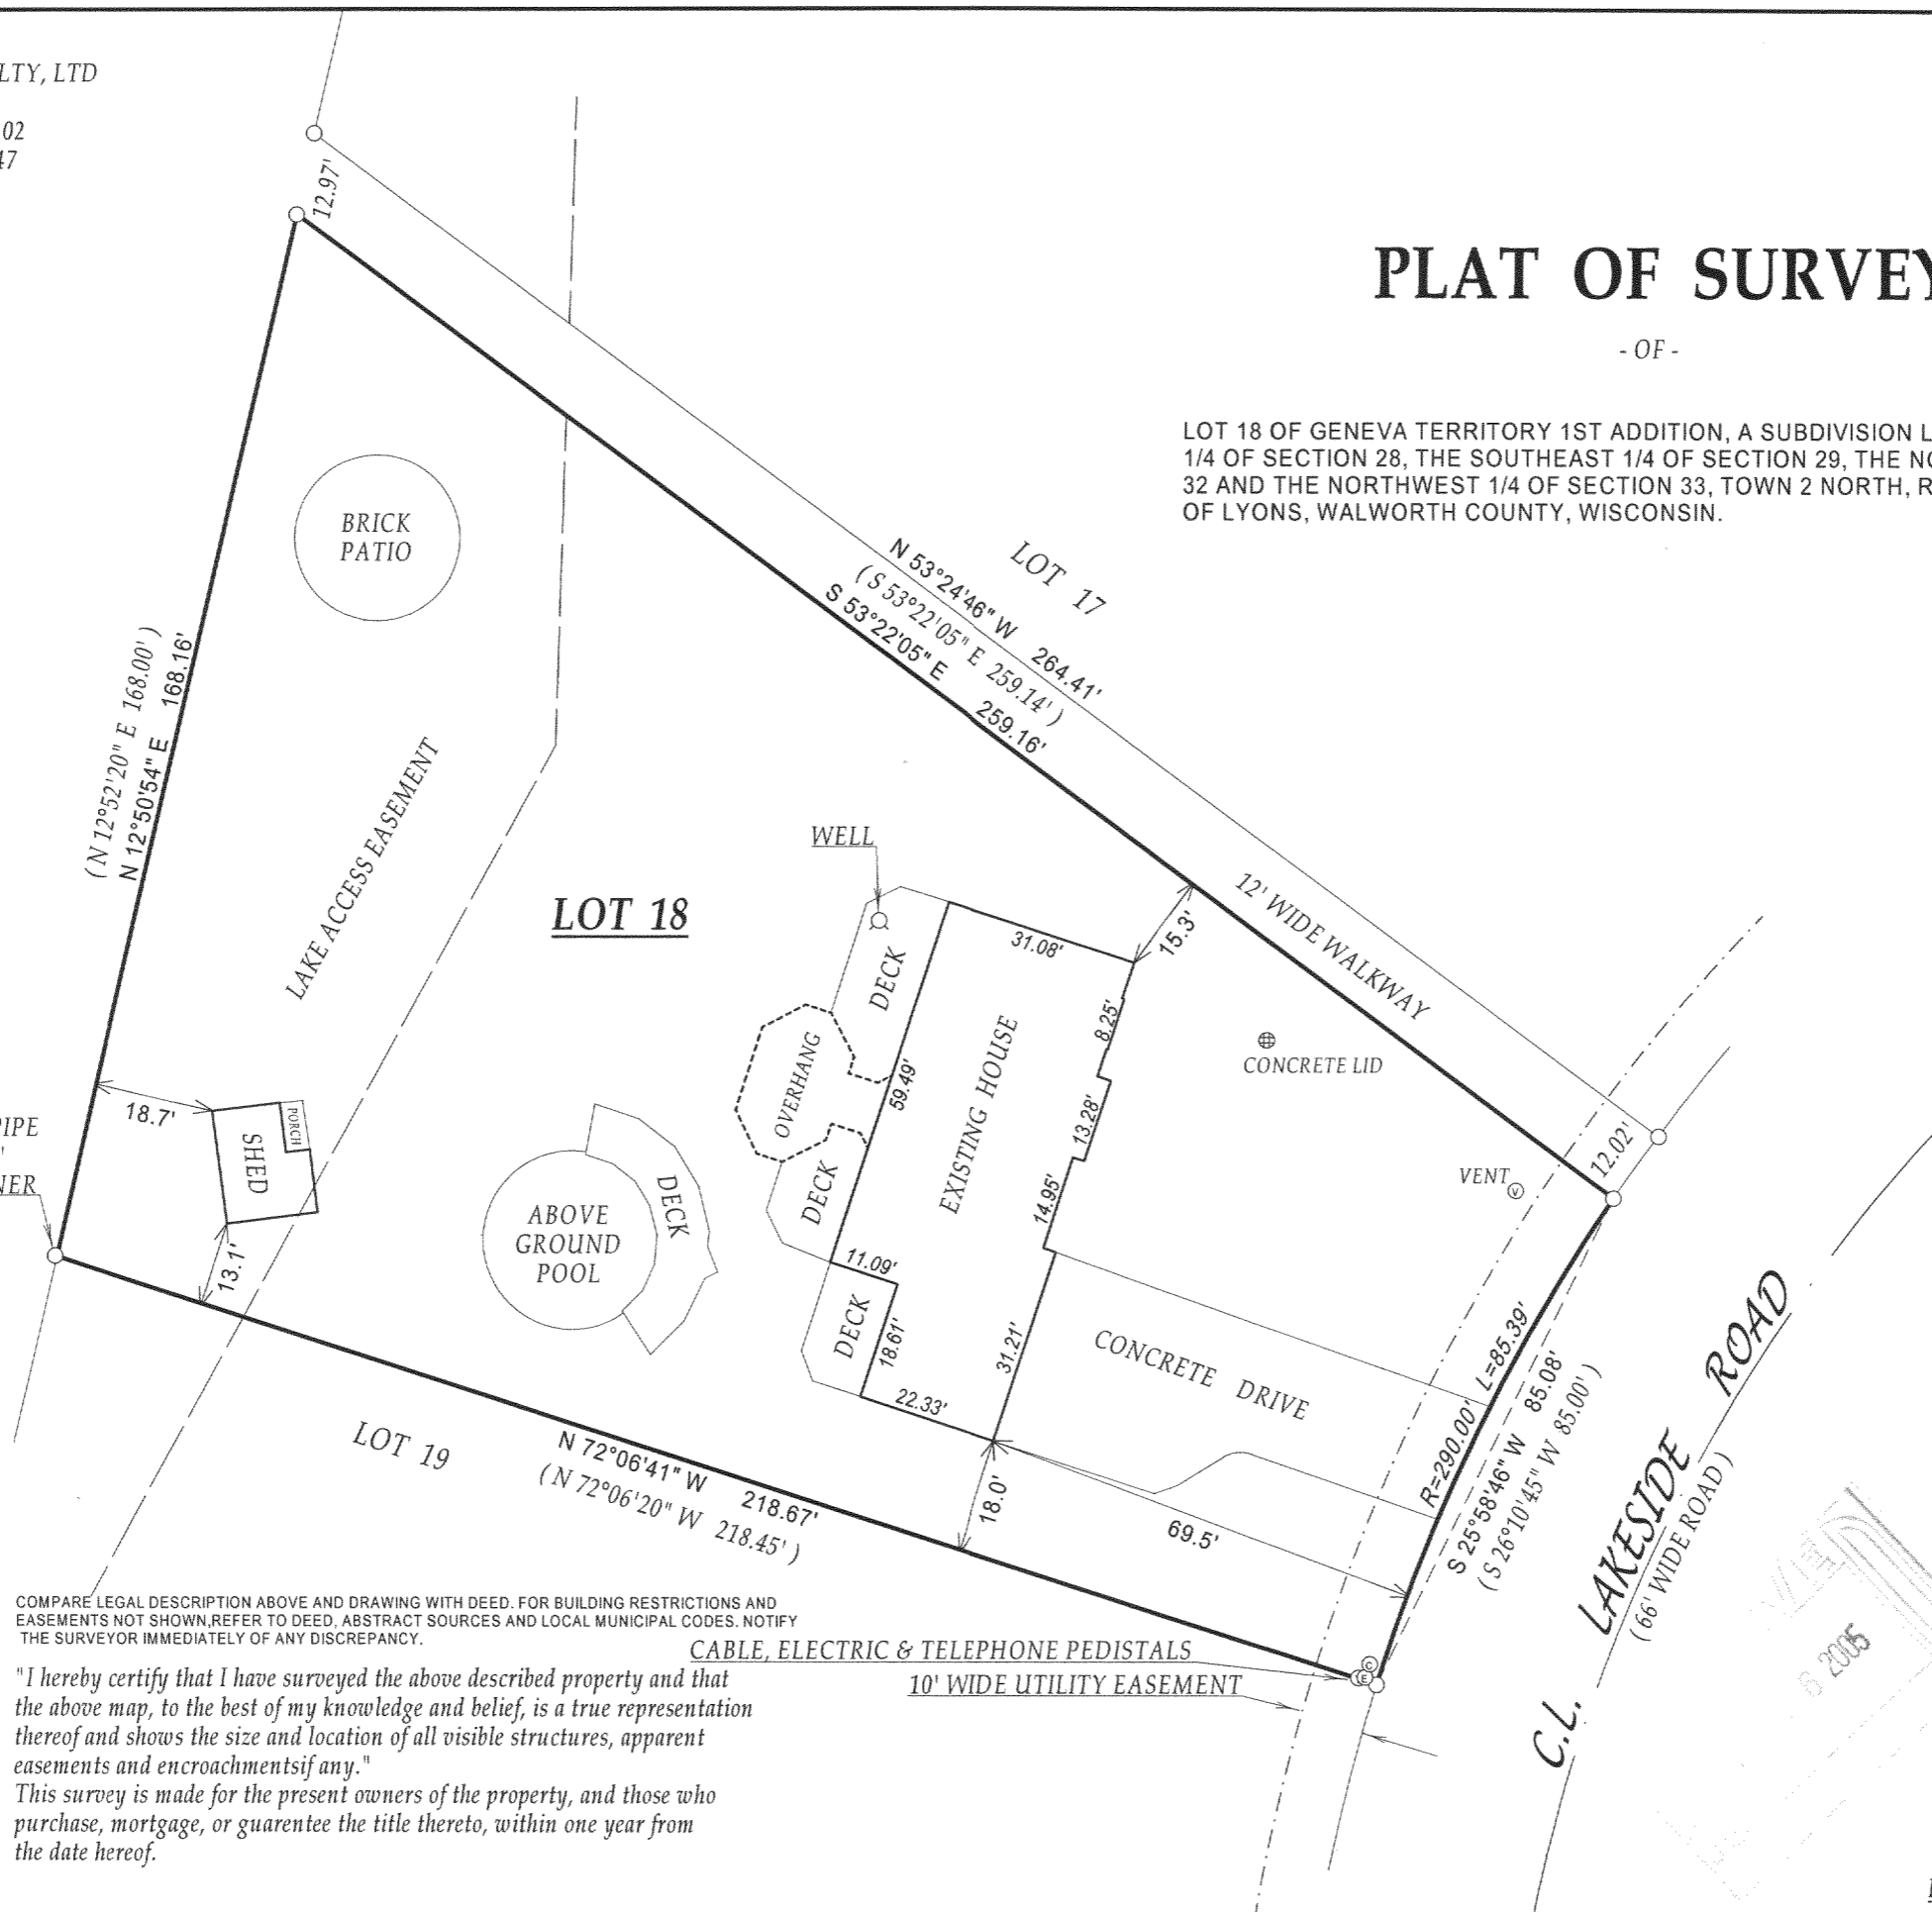

COMPARE LEGAL DESCRIPTION ABOVE AND DRAWING WITH DEED. FOR BUILDING RESTRICTIONS AND EASEMENTS NOT SHOWN, REFER TO DEED, ABSTRACT SOURCES AND LOCAL MUNICIPAL CODES. NOTIFY THE SURVEYOR IMMEDIATELY OF ANY DISCREPANCY.

"I hereby certify that I have surveyed the above described property and that the above map, to the best of my knowledge and belief, is a true representation thereof and shows the size and location of all visible structures, apparent easements and encroachments if any."  
 This survey is made for the present owners of the property, and those who purchase, mortgage, or guarantee the title thereto, within one year from the date hereof.

CABLE, ELECTRIC & TELEPHONE PEDISTALS  
 10' WIDE UTILITY EASEMENT

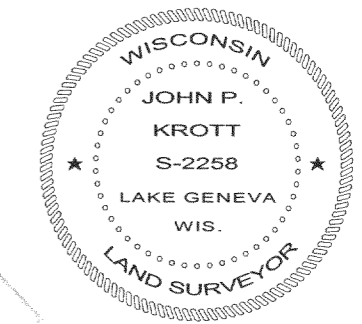

*John P. Krott*  
 JOHN KROTT S - 2258  
 Wisconsin Registered Land Surveyor  
 (original if signed in red)

DATED THIS THE 16th DAY OF MAY 2005.

218-1542