


PLAT OF SURVEY

PATHFINDER SURVEYING
FORMERLY KOLB LAND CONSULTING
929 WILLIAMS STREET LAKE GENEVA, WI. 53147
(414) 248-3687

ORDERED BY: COLDWELL BANKER
838 MAIN ST.
LAKE GENEVA, WI. 53147

DATE: 7/29/1998

DESCRIPTION: OUT-LOT 3 HEATHERIDGE SUBDIVISION A SUBDIVISION LOCATED IN THE NORTH
1/2 OF THE SOUTHWEST 1/4 OF SECTION 18, T2N, R18E, WALWORTH COUNTY, WISCONSIN

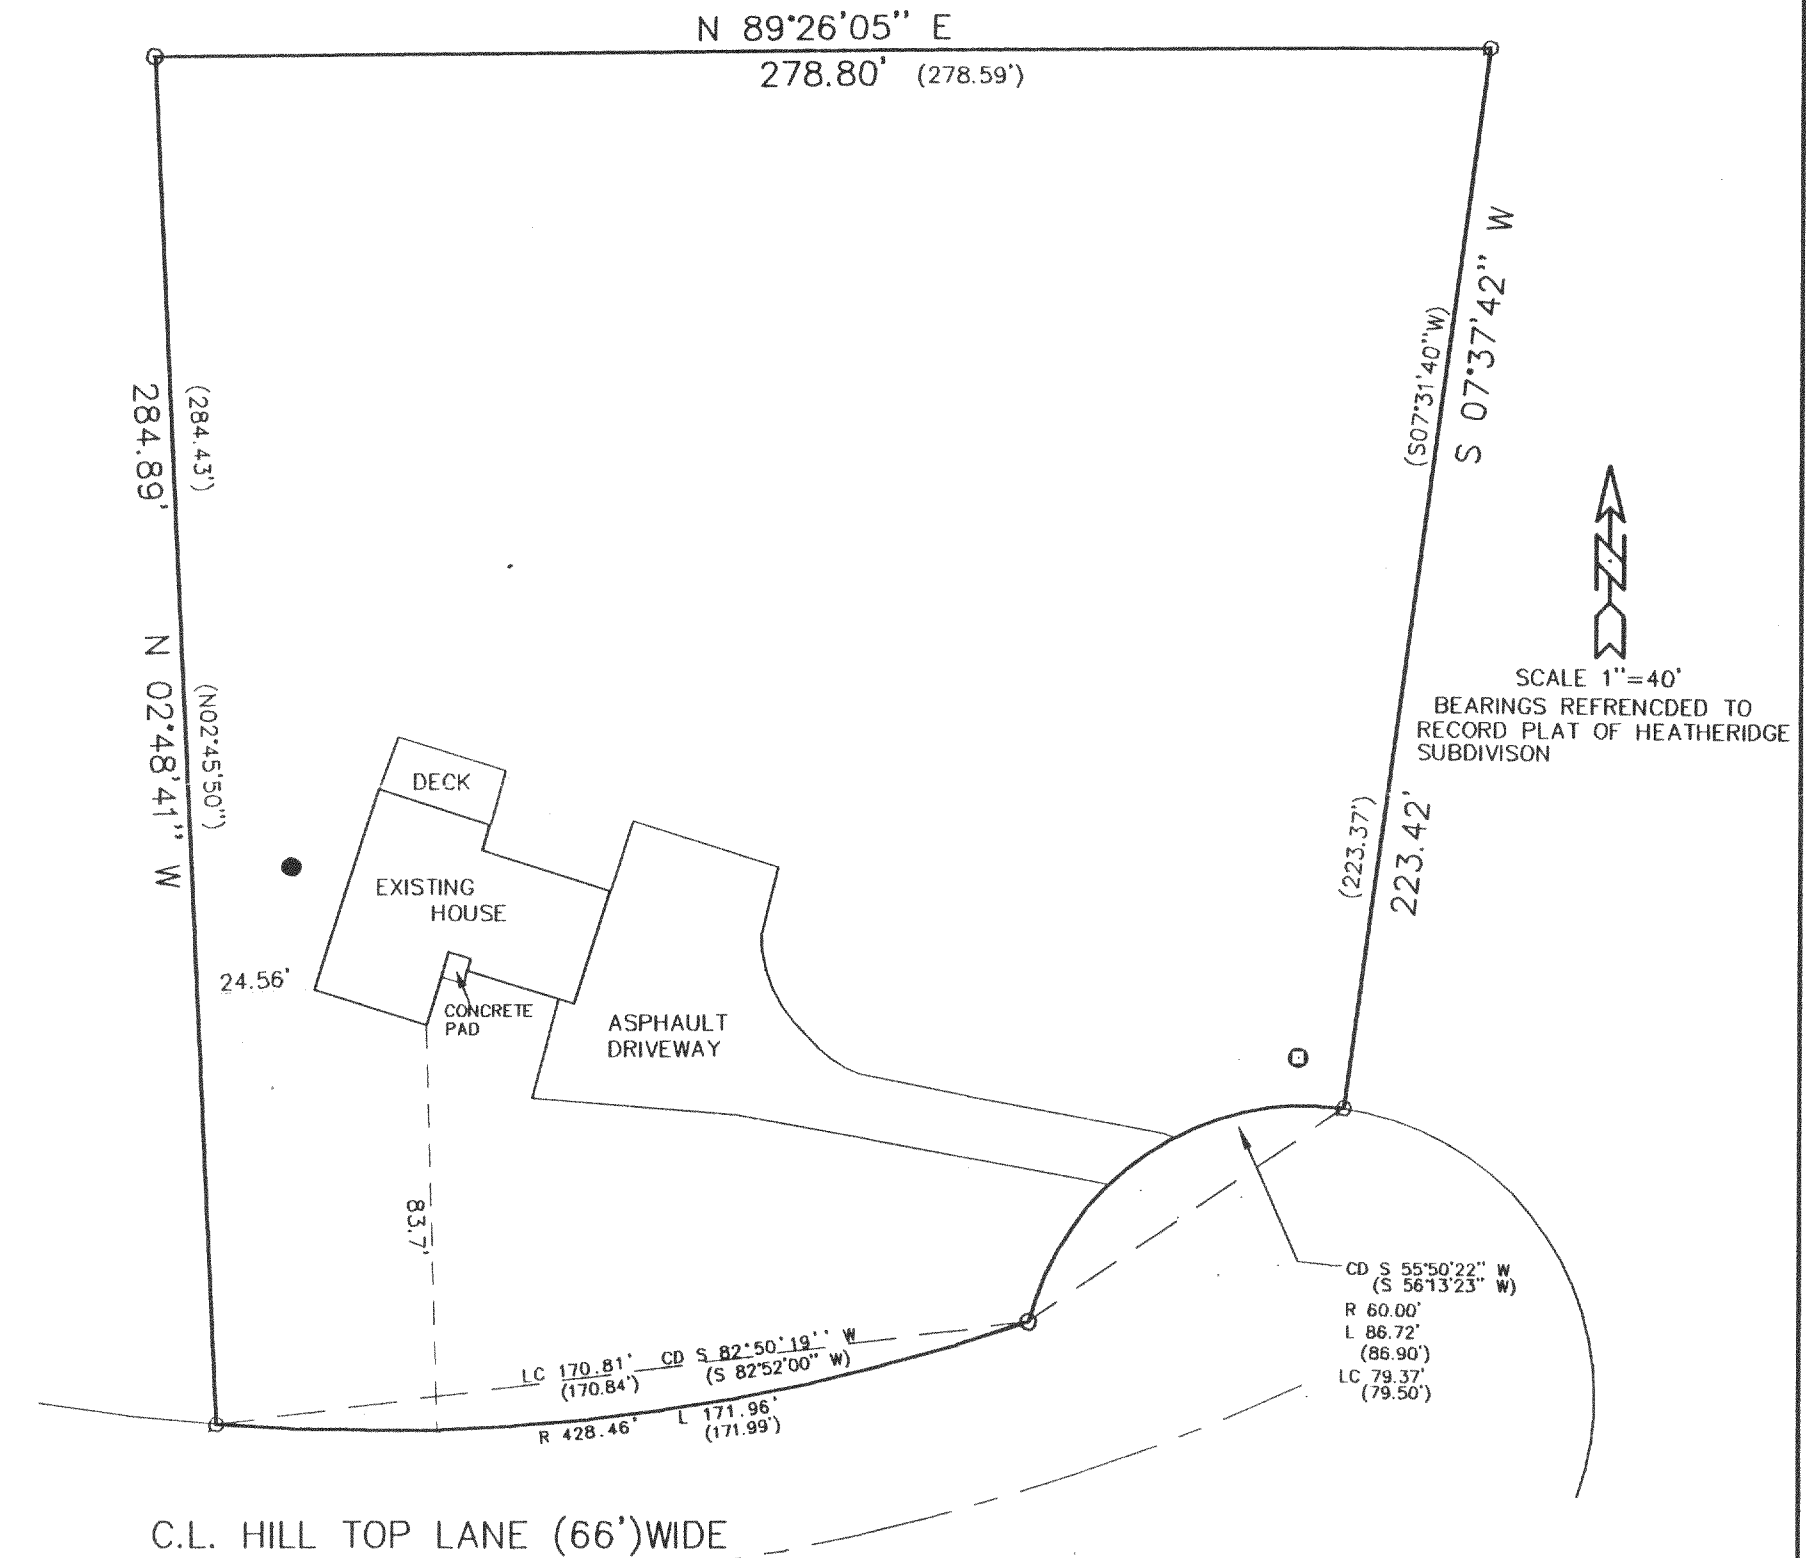



LEGEND

- FOUND 1 IN. DIA. IRON PIPE
- FOUND 2 IN. DIA. IRON PIPE
- WELL
- VENT
- (XXX) RECORDED AS

THE ABOVE MAP IS A TRUE REPRESENTATION THEREOF AND SHOWS THE SIZE AND LOCATION OF ALL THE PROPERTY, EXTERIOR BOUNDARIES, THE LOCATION OF ALL VISIBLE BOUNDARY FENCES, APPARENT EASEMENTS, ROADWAYS AND VISIBLE ENCROACHMENTS, IF ANY

THIS SURVEY IS MADE FOR THE USE OF THE PRESENT OWNERS OF THE PROPERTY, AND ALSO THOSE WHO PURCHASE, MORTGAGE OR GUARANTEE TITLE THERETO WITHIN ONE (1) YEAR FROM DATE HERETO.

John P. Krott
JOHN P. KROTT, R.L.S. 2258

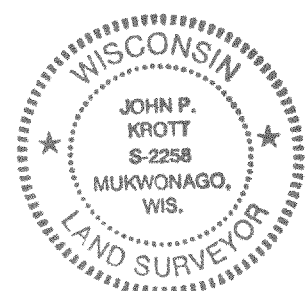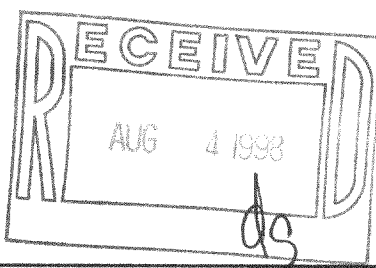

NOTE: THIS IS NOT A CERTIFIED COPY
UNLESS SEAL IS IN RED.
JOB NUMBER #98130 2-18-NDE00013

NDE-13

218-1004