SCALE 1"= 50"

JAHNKE & JAHNKE ASSOCIATES INC.

Consultants in Engineering, Planning, Subdivisions and Surveying

711 W. MORELAND BLVD. -- WAUKESHA, WISCONSIN 53188

THE W. MUNELAND DETU. " WAGRESTA, WISCUMSTR SOLI

FAX (414) 542-7698

FOR: KETTLE CREEK HOMES

LEGAL DESCRIPTION: Lot 7, Block 3, FIRST ADDITION TO KNOLL BROOK, part of the Northwest 1/4 of the Southwest 1/4 of the Southwest 1/4 of the Southwest 1/4 of Section 10, T2N, R18E, Town of Lyons, Walworth County, Wisconsin.

TELEPHONE (414) 542-5797

Bench Mark 792.05 (USGS) East sanitary sewer invert located in manhole in cul-de-sac as shown.

803.9 - Existing elevation

Suggested Residence Grade: First Floor 807.5*

Top of Foundation 806.5*

Garage Opening <u>805.70</u>
5/4/98 - Basement constructed

Existing Top of Foundation 806.50

*suggested grades only and located as shown.

• Iron pipes found


NKOJ-

NOTE: No pipes set as part of survey.

NOTE: Expose sanitary sewer lateral before construction to verify gravity flow from the basement.

REFERENCE: Bearing relate to the west lie of the SW 1/4 of Section 10-2-18 which was assumed as $S0^{\circ}27'W$.

SURVEY CERTIFICATE: I have surveyed the above described property and the map shown is a true representation thereof and shows the size and location of the property, its exterior boundaries, the location and dimensions of all visible structures thereon, fences, apparent easements and roadways and visible encroachments if any. This survey is made for the exclusive use of the present owners of the property and also those who purchase, mortgage or guarantee the title thereto within one (1) year from date hereof and as to them I warrant the accuracy of said survey and map.

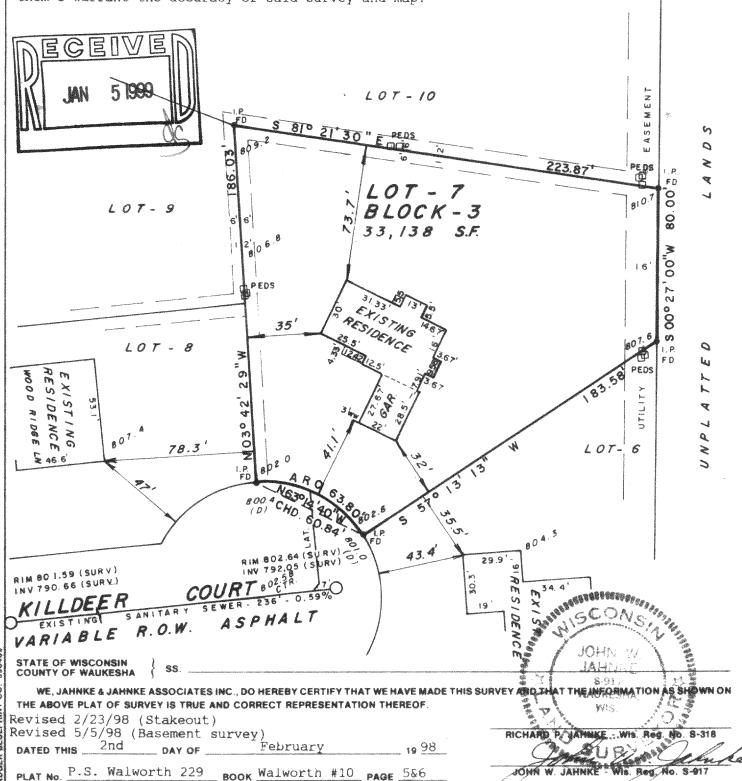

518-1033