


Plat of Survey

of

Lot 2 of Certified Survey Map No. 2219,
recorded in Vol. 10 of Certified Survey Maps of Walworth County
on Page 338, located in the Southeast 1/4 of Section 21, Town 2
North, Range 18 East, Town of Lyons, Walworth County, Wisconsin.

Surveyed for: **Karen Radcliffe c/o**
Coldwell Banker - Geneva Lakes Area Realtors
838 Main Street
Lake Geneva, Wisconsin. 53147

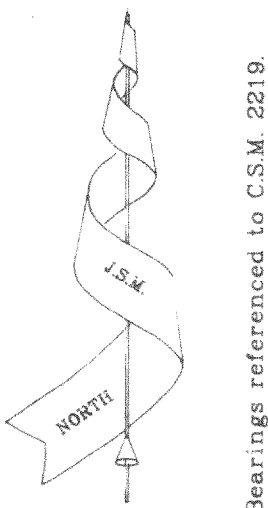

Bearings referenced to C.S.M. 2219.

Curve Data

I = 98°29'41"
R = 60.00
A = 103.14
C = 90.90
CHB = N 36°03'48" W

Note: Wood lathe "along property lines" were not set by Jensen & Olson
Land Surveying, LLC and in some cases are not on the property lines.

Copyright © 1998 by Jensen & Olson Land Surveying, LLC

All rights reserved. No part of this survey plat may be reproduced
or transmitted in any form by any means - graphic, electronic, or
mechanical, including photocopying, tracing, or information storage
and retrieval systems - without permission in writing from Douglas G.
Olson, Jensen & Olson Land Surveying, LLC.


I, Douglas G. Olson, Wisconsin Registered Land Surveyor, do
hereby certify that this survey was performed by me, or under my
direction in full compliance with the owner's / agent's instructions
and Chapter A-E 7 of the Wisconsin Administrative Code "Minimum
Standards for Property Surveys"; and that this map is as accurate
representation thereof to the best of my knowledge and belief.

Date: 11-5-98

Douglas G. Olson



R.L.S. 2093

Private Road
(66' Wide)

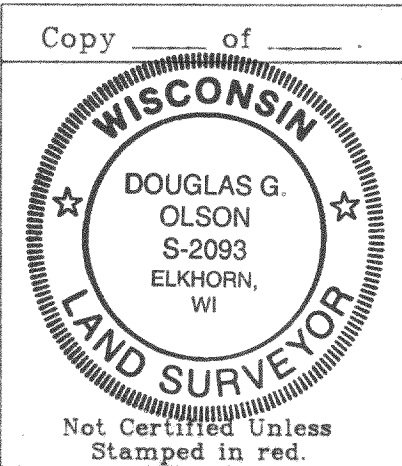

Note: This survey plat is not
certified unless signed
and sealed in red ink.

Note: This survey is subject to Wisconsin lien laws.
This Plat of Survey is the notice of intent
to file lien. Lien waiver required.

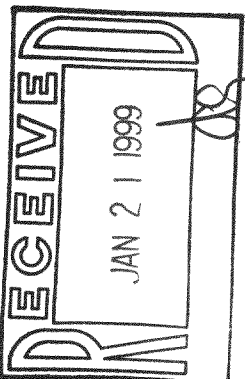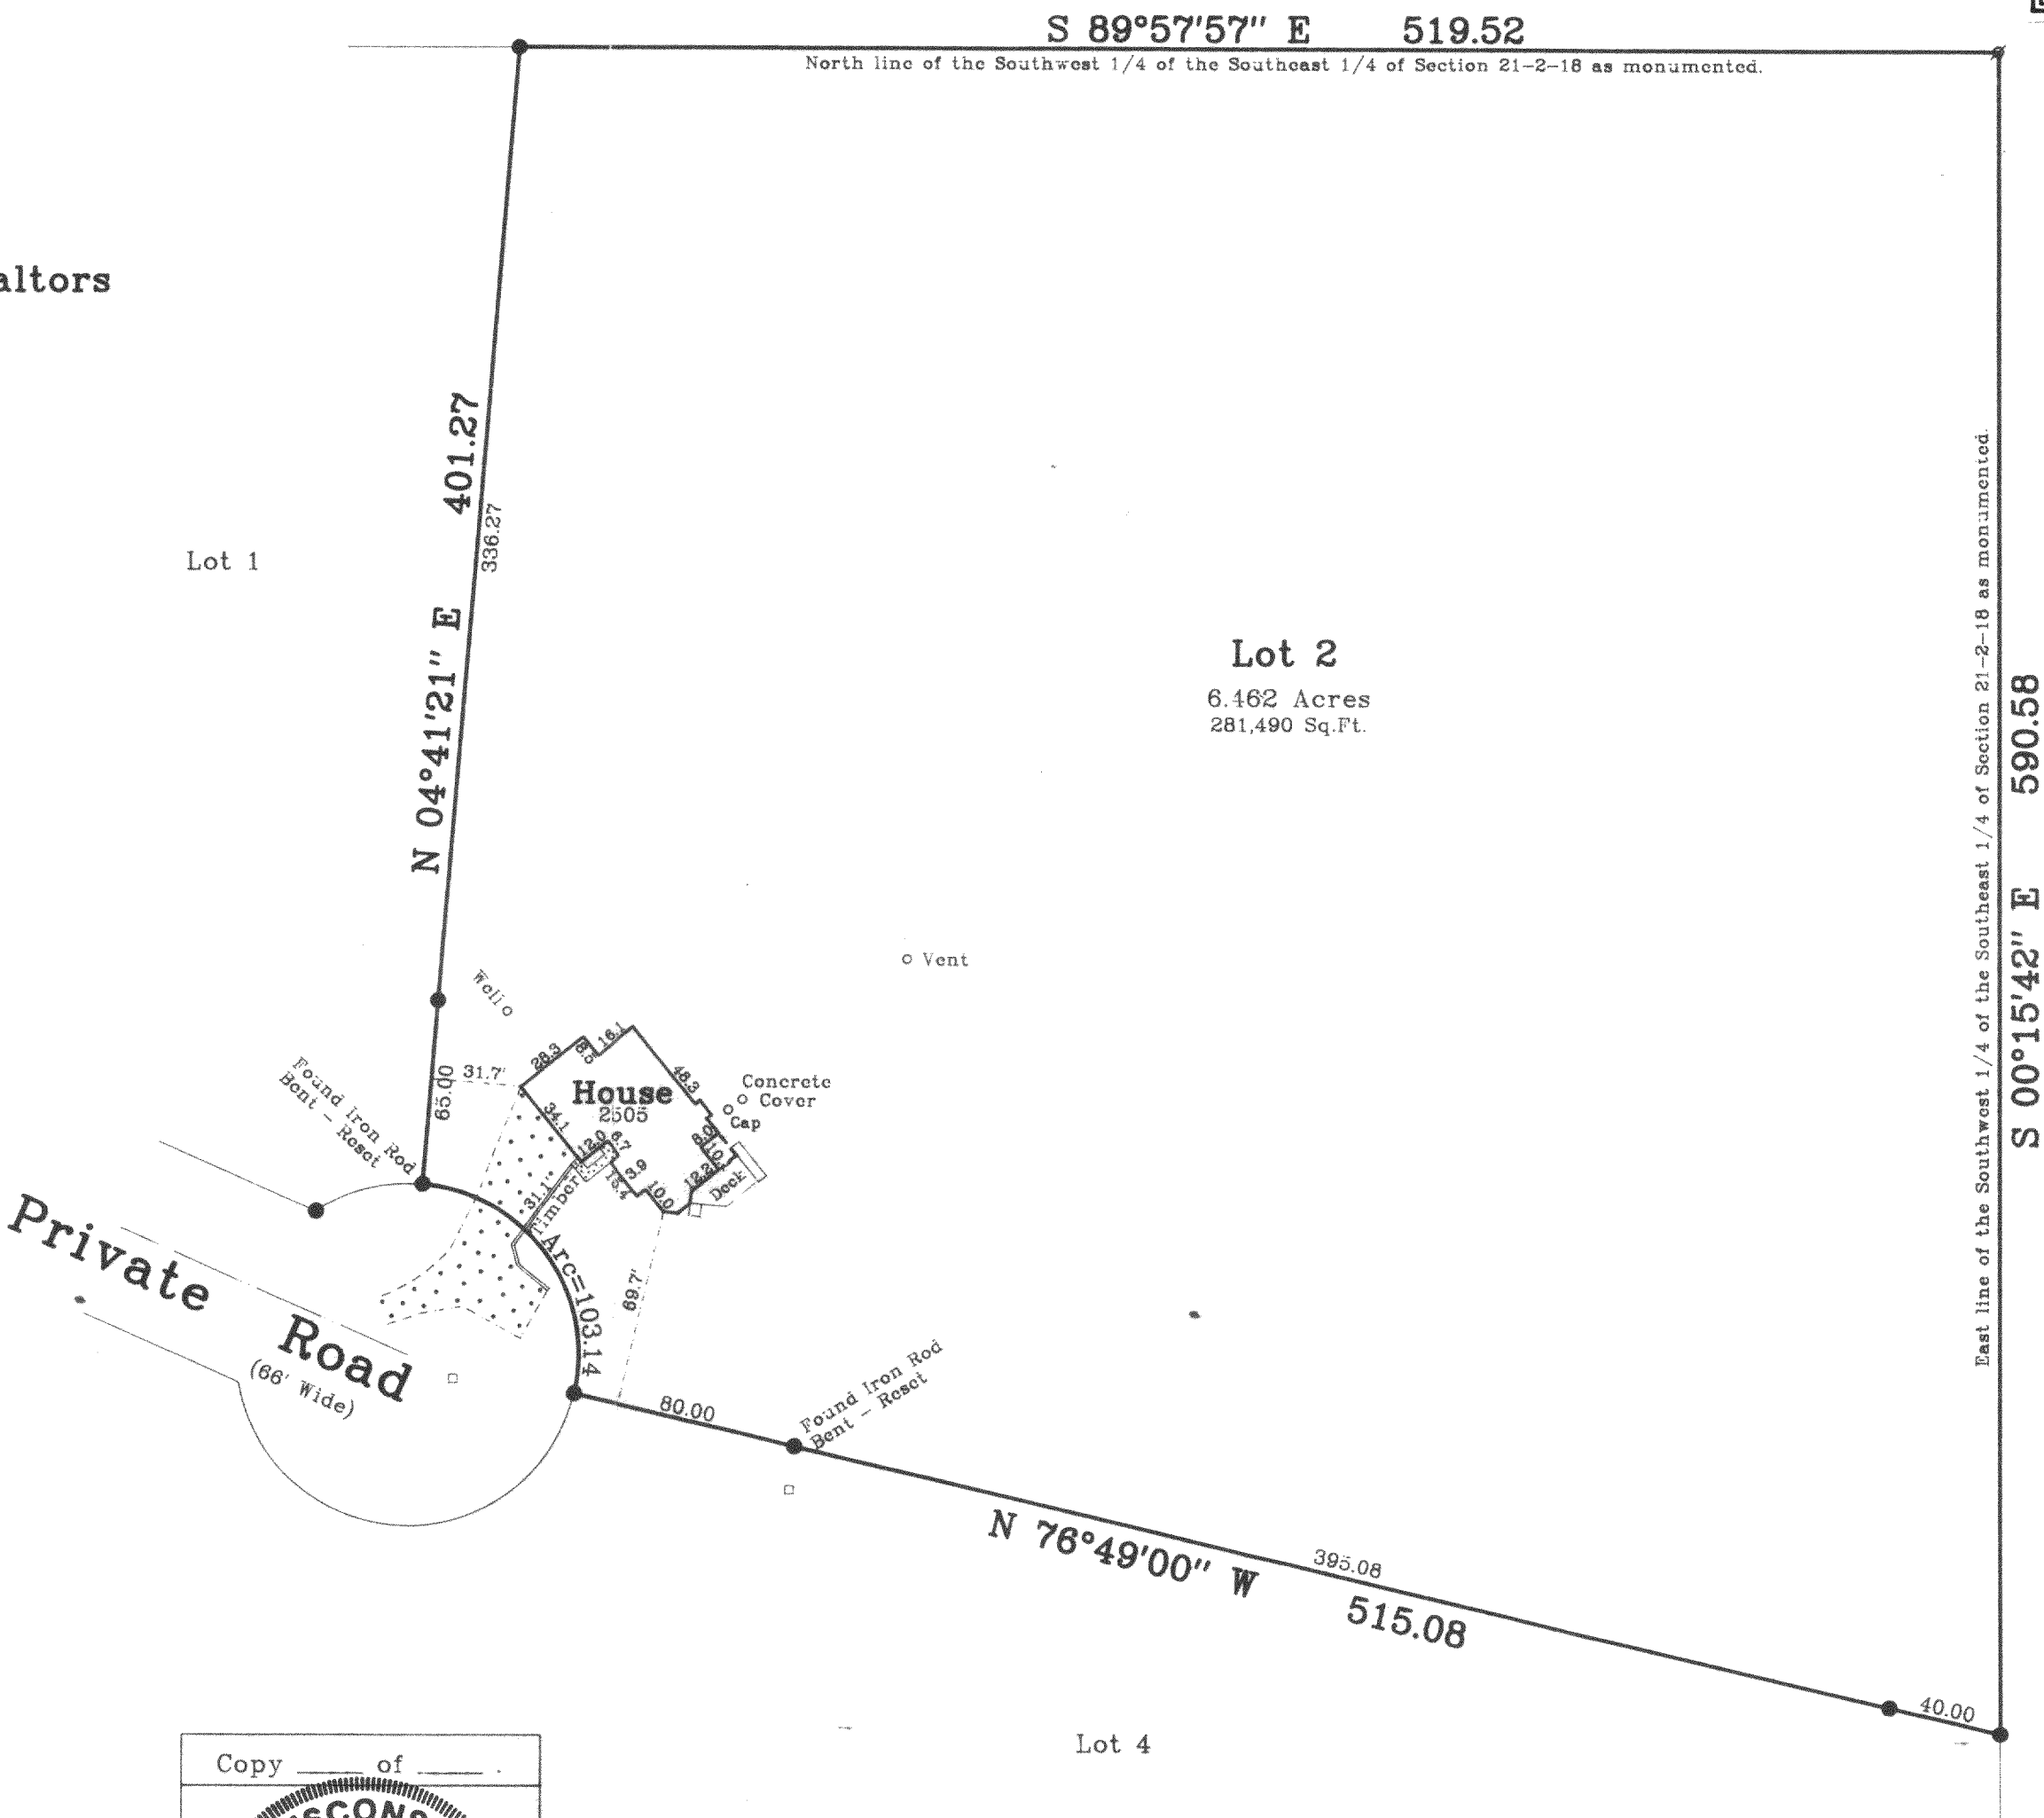

Mapping date: Nov. 5, 1998.

Revisions:

Scale in Feet

1"= 60'



Jensen & Olson Land Surveying, LLC

45 South Wisconsin Street P.O. Box 322

Elkhorn, Wisconsin. 53121

Telephone: (414) 723-3434

Facsimile: (414) 723-8044

Legend

- Found Iron Pipe
- Found Iron Rod
- Found Lathe
- Recorded Information
- Concrete Surface
- Gravel Surface

Sheet 1 of 1 Sheets.

Job Reference Number

1998.097

1998.097

218-1043