PATHFINDER SURVEYING
FORMERLY KOLB LAND CONSULTING
929 WILLIAMS STREET LAKE GENEVA, W. 53147
(262) 248-3697

ORDERED BY:


R J AMANN BUILDERS


DATE: 1-7-2000

DESCRIPTION:

LOT 2 OF CERTIFIED SURVEY MAP NO. 1188 A C.S.M. BEING LOT 5 OF LYON'S INDUSTRIAL PARK AND LOCATED IN THE SE 1/4 OF SECTION 19, T2N, R18, WALWORTH

COUNTY, WISCONSIN.

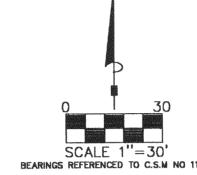

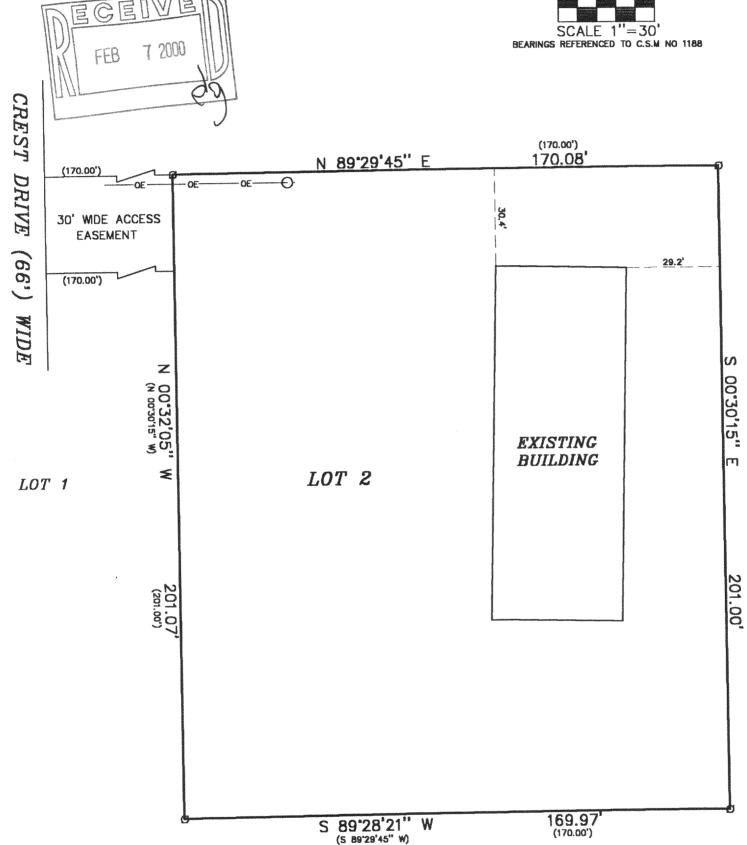

THE ABOVE MAP IS A TRUE REPRESENTATION THEREOF AND SHOWS THE SIZE AND LOCATION OF ALL THE PROPERTY, EXTERIOR BOUNDARIES, THE LOCATION OF ALL VISIBLE BOUNDARY FENCES , APPARENT EASEMENTS , ROADWAYS AND VISIBLE ENCROACHMENTS, IF ANY

THIS SURVEY IS MADE FOR THE USE OF THE PRESENT OWNERS OF THE PROPERTY . AND ALSO THOSE WHO PURCHASE . MORTGAGE OR GURANTEE TITLE THERETO WITHIN ONE (1) YEAR FROM DATE HERETO.

LEGEND

FOUND IRON PIPE

POWER POLE 0

(XXXXX) RECORDED AS

- OVERHEAD UTILITIES



NOTE: THIS IS NOT A CERTIFIED COPY JOB NUMBER # 99299 NA 1188 00002