
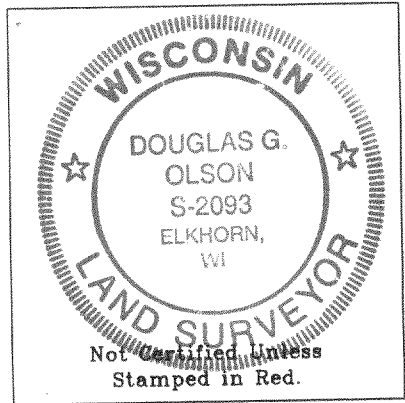
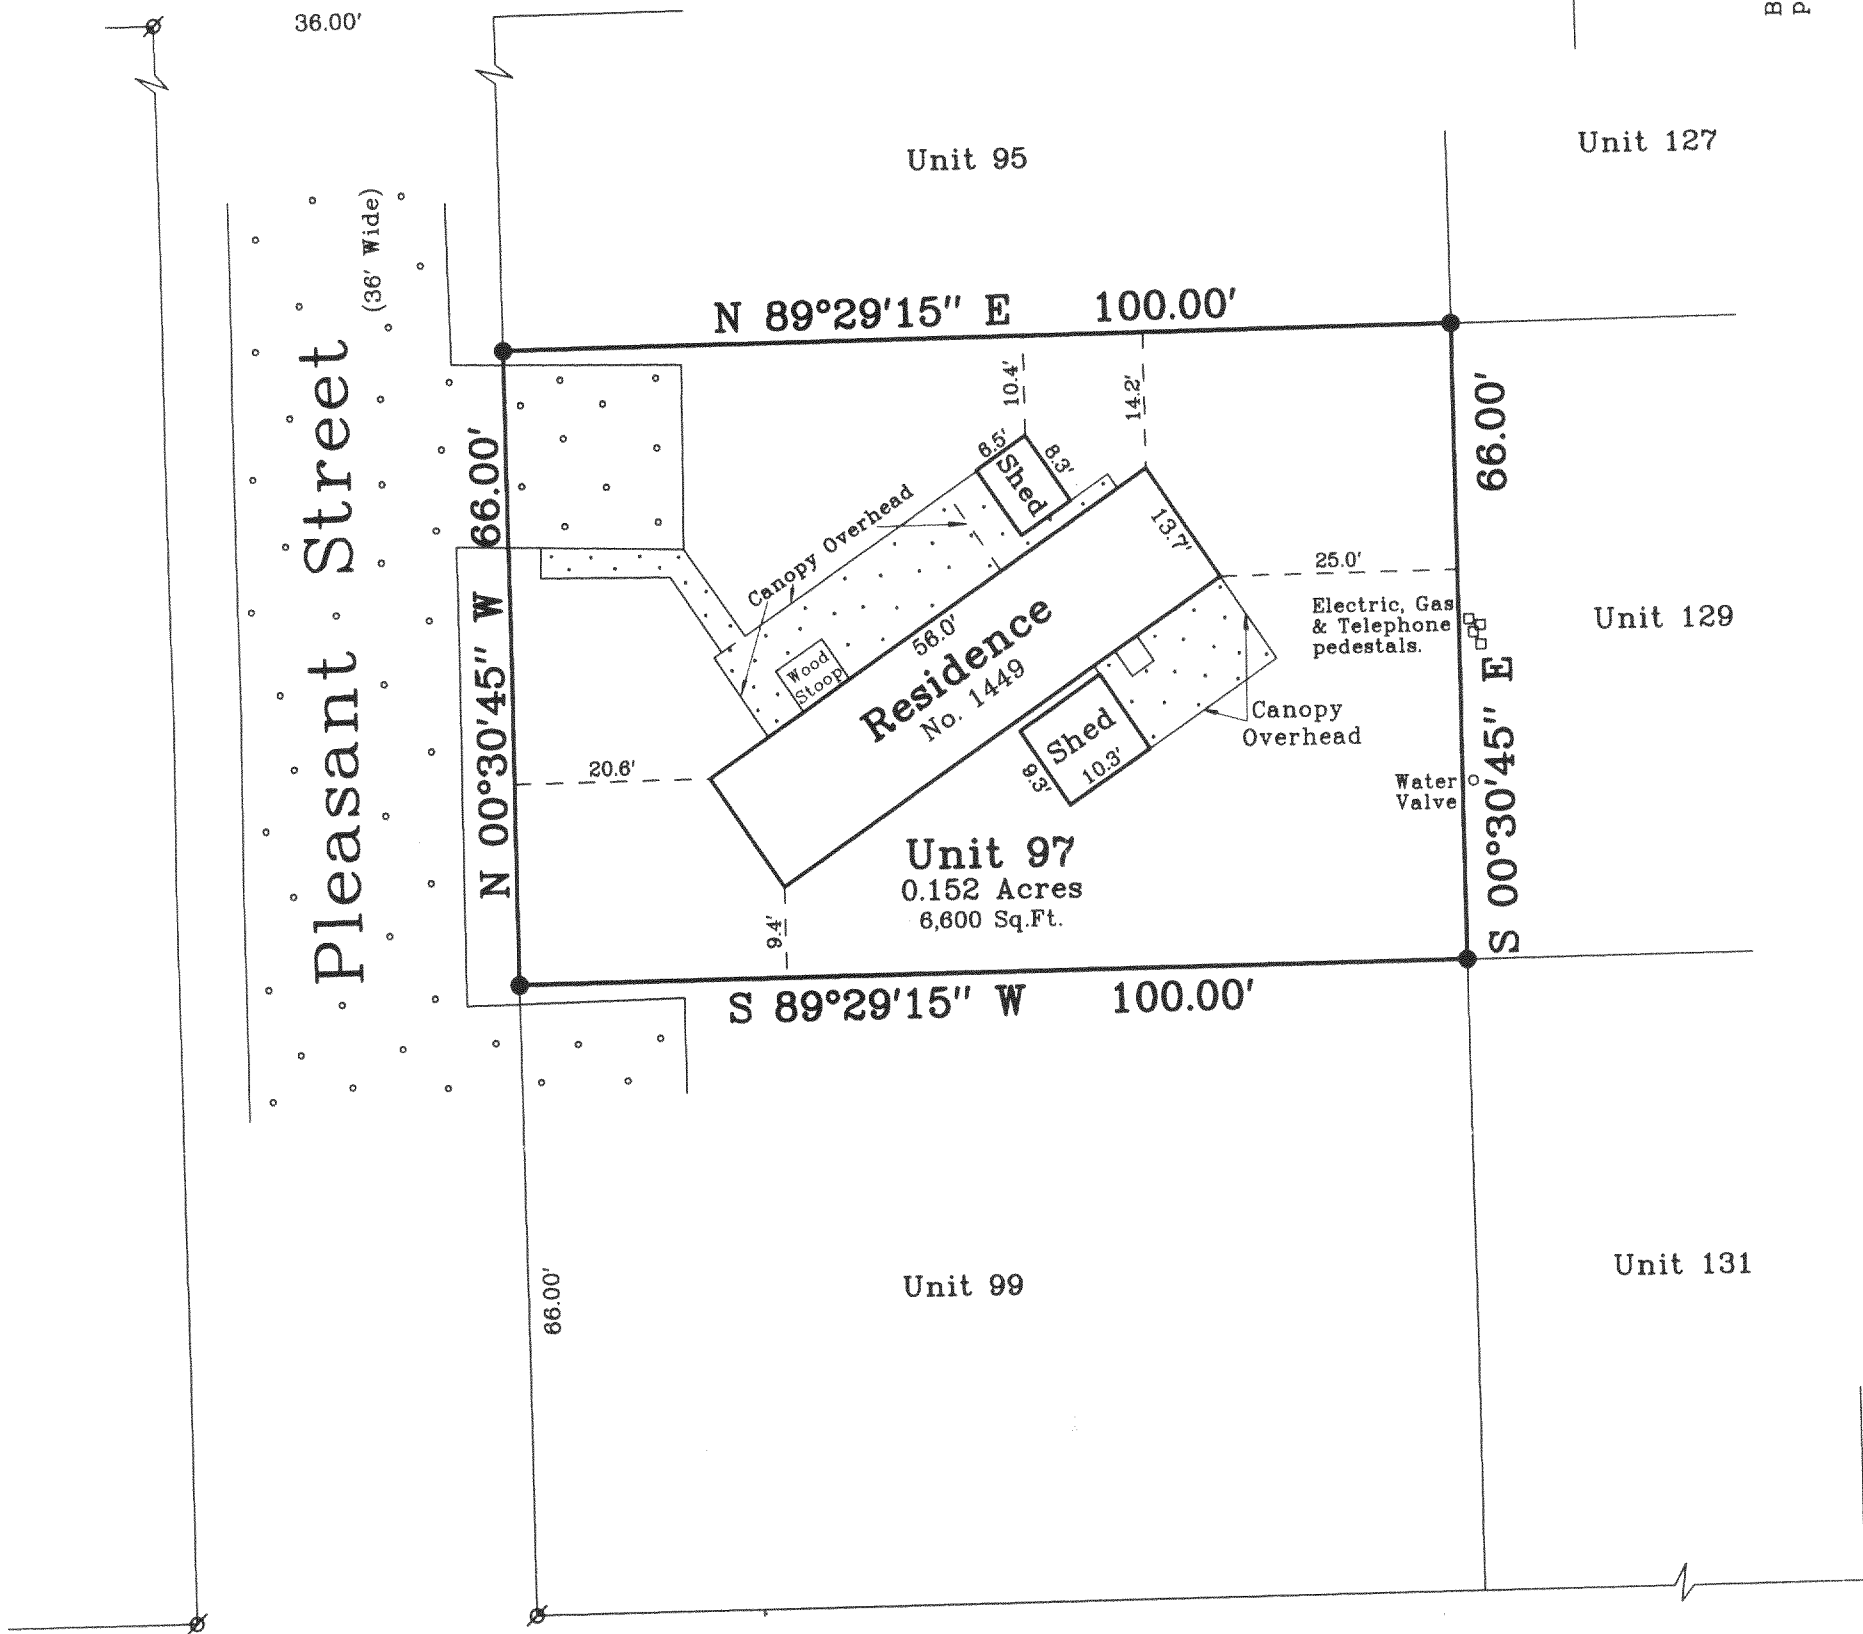



Plat of Survey

of  
Unit 97 of Phase I of Country Estates,  
a condominium located in the Northwest 1/4 of Section 8, Town 2 North,  
Range 18 East, Town of Lyons, Walworth County, Wisconsin.

Surveyed for: Coldwell Banker, Leith & Associates  
102 North Wisconsin Street  
Elkhorn, Wisconsin. 53121

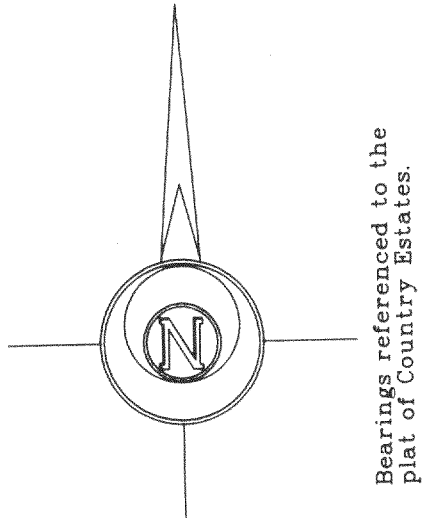

Prairie Lane (36' Wide)

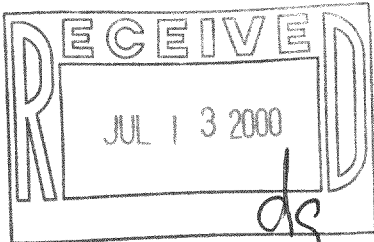

Copyright c 2000 by Jensen & Olson Land Surveying, LLC.

All rights reserved. No part of this survey plat may be reproduced or transmitted in any form by any means - graphic, electronic, or mechanical, including photocopying, tracing, or information storage and retrieval systems - without permission in writing from Douglas G. Olson, Jensen & Olson Land Surveying, LLC.

I, Douglas G. Olson, Wisconsin Registered Land Surveyor, do hereby certify that this survey was performed by me or under my direction in full compliance with the owner's/agent's instructions and Chapter A-E 7 of the Wisconsin Administrative Code "Minimum Standards for Property Surveys"; and that this map is an accurate representation thereof to the best of my knowledge and belief.

Douglas G. Olson  
Wisconsin Registered Land Surveyor - 2093

Notes:

- 1) This survey plat is not certified unless signed and sealed in red ink.
- 2) This survey is subject to Wisconsin lien laws. This Plat of Survey is the notice of intent to file lien. Lien waiver required.

Legend

- Found Iron Pipe
- Set Iron Rod, 3/4" diameter
- Recorded Information
- Concrete Surface
- Asphalt Surface

Jensen & Olson Land Surveying, LLC

45 South Wisconsin Street P.O. Box 322  
Elkhorn, Wisconsin. 53121  
Telephone: (262) 723-3434  
Facsimile: (262) 723-8044

Scale: 1" = 20'



Survey date: June 19, 2000.  
Revisions:

Sheet 1 of 1 Sheets.

Job Reference Number:

2000.086

218-1186  
NCS-97