
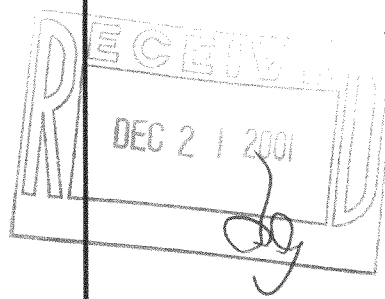


ALVINA'S ROAD

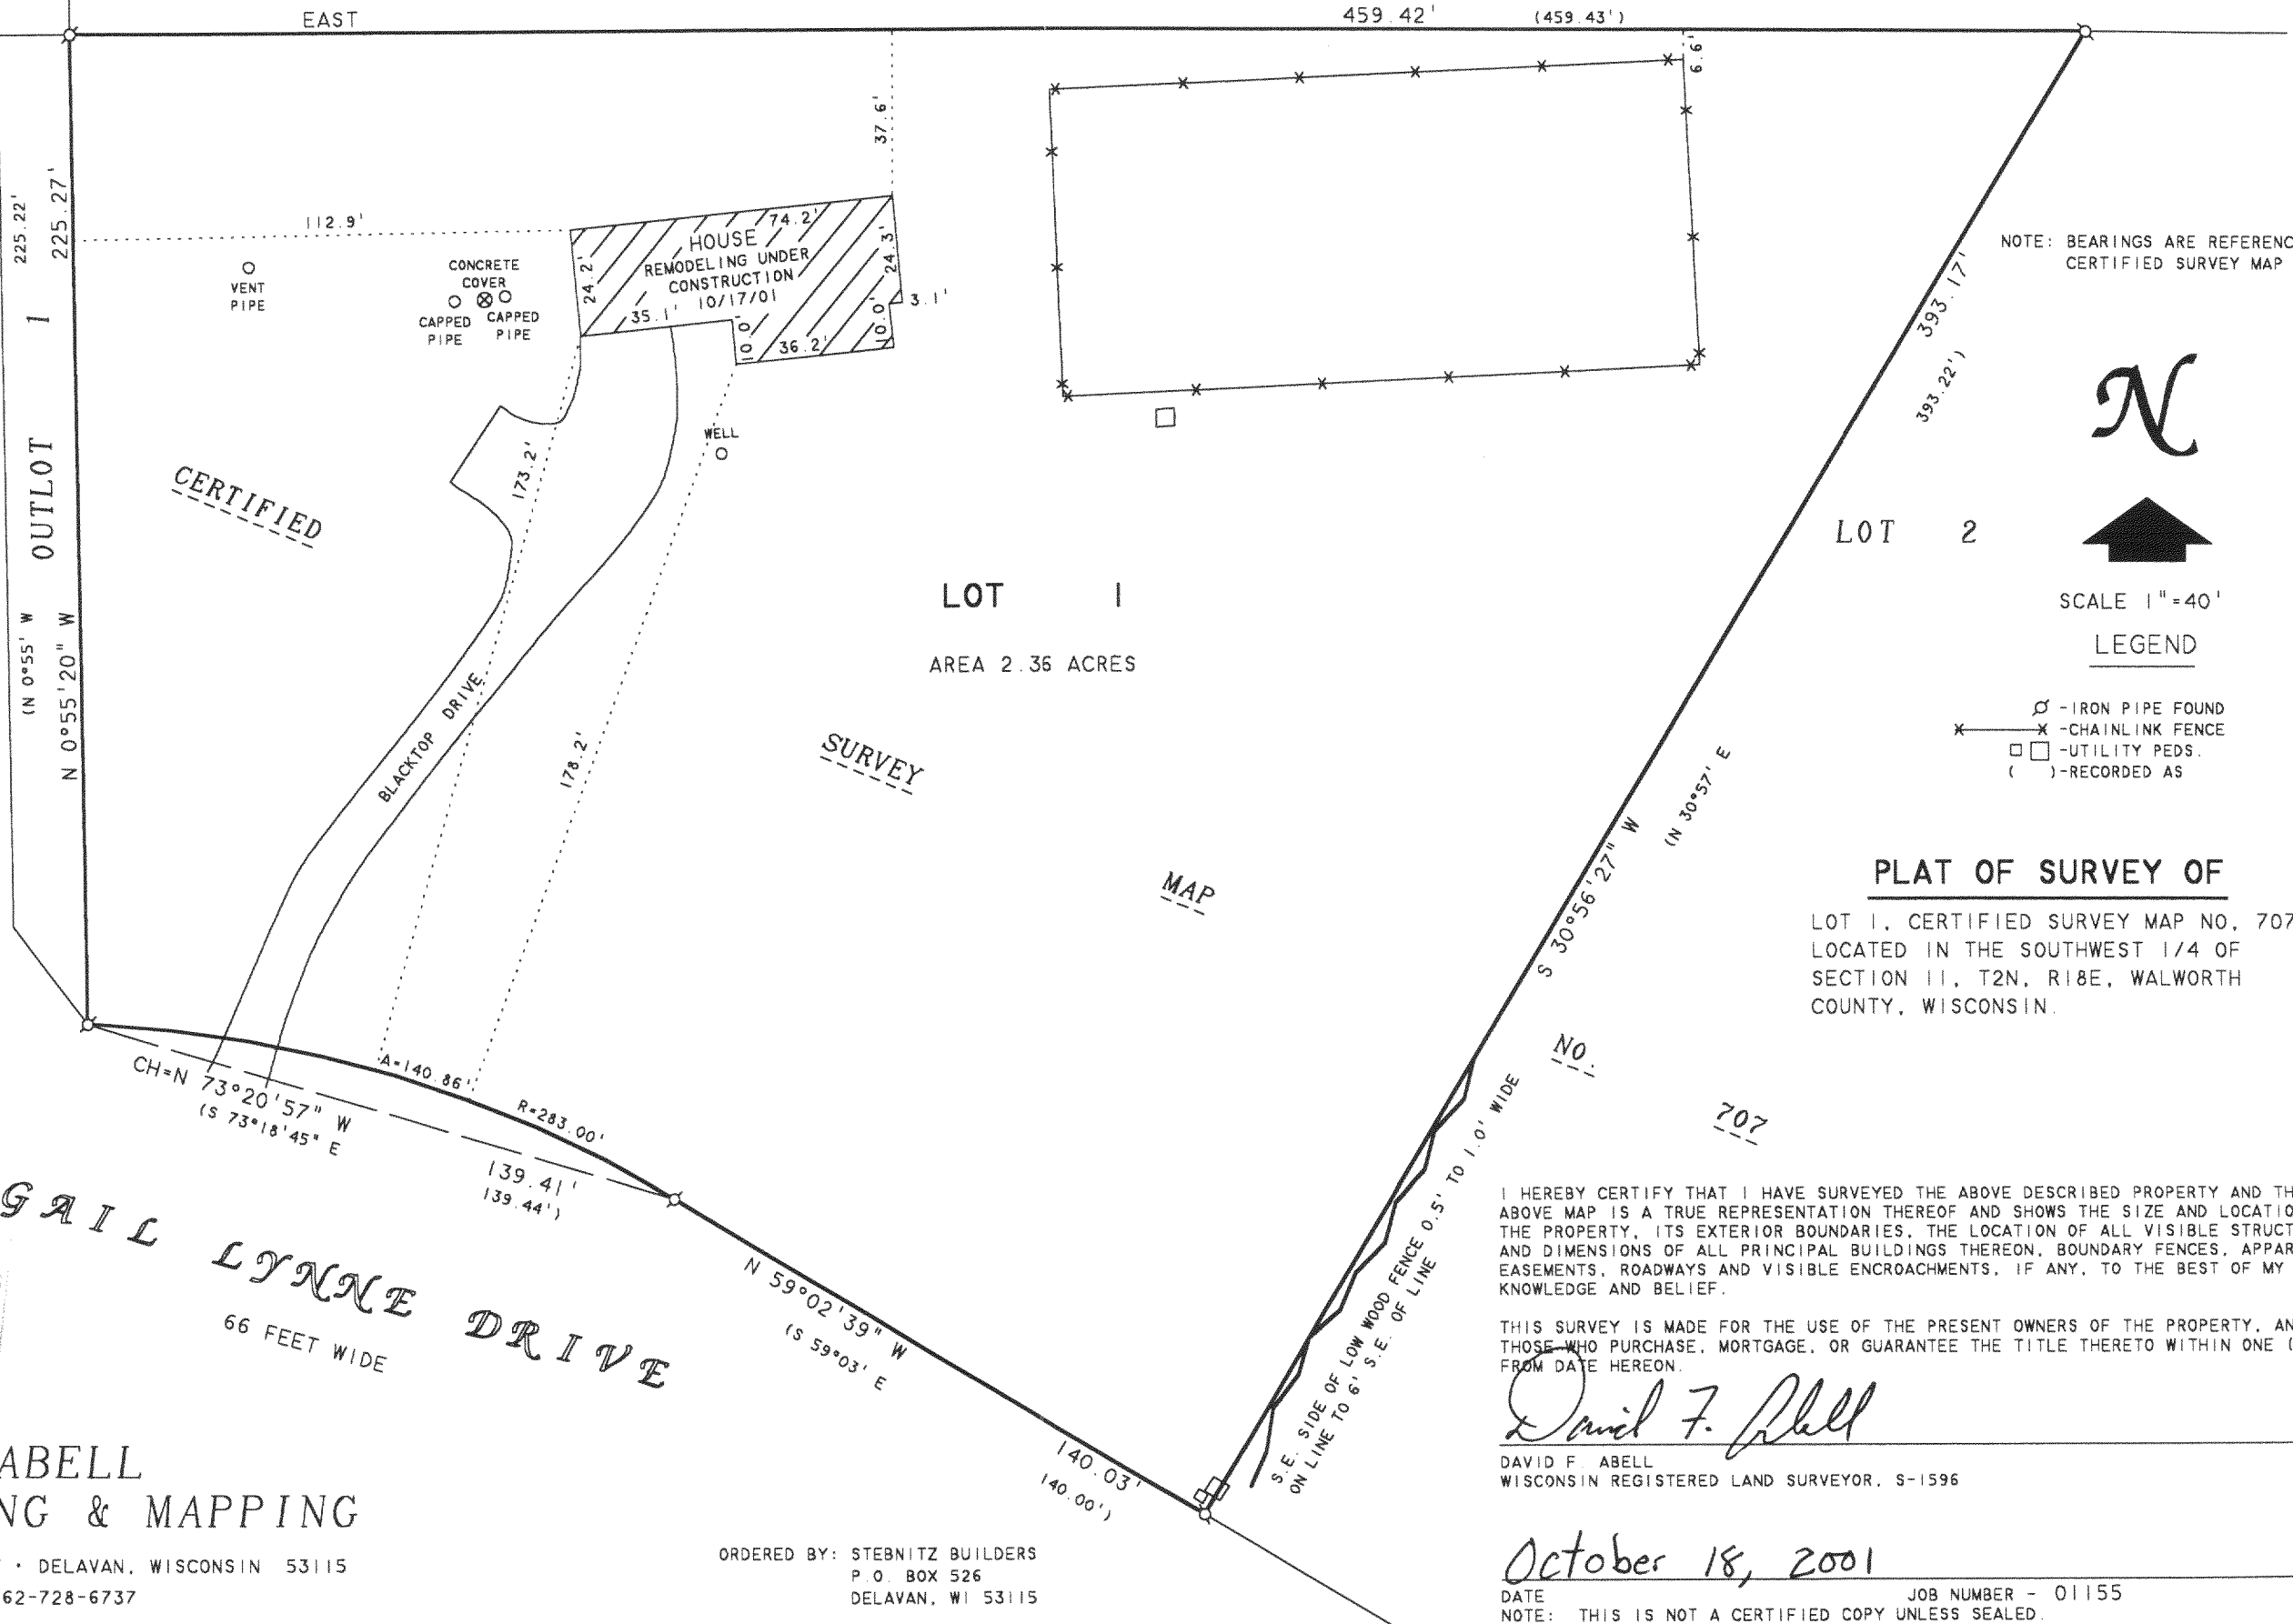

GAIL LYNNE DRIVE

66 FEET WIDE

ABELL
SURVEYING & MAPPING

1140 SEQUOIA STREET • DELAVAN, WISCONSIN 53115
262-728-6737

ORDERED BY: STEBNITZ BUILDERS
P.O. BOX 526
DELAVAN, WI 53115

218-1280

NA-707-11