
PLAT OF SURVEY -OF-

LOT 6, LYONS HILLSIDE SUBDIVISION, A SUBDIVISION LOCATED IN PART OF THE NORTHWEST 1/4 OF THE SOUTHEAST 1/4 OF SECTION 10, TOWNSHIP 2 NORTH, RANGE 18 EAST, IN THE TOWN OF LYONS, COUNTY OF WALWORTH AND STATE OF WISCONSIN.

SURVEY FOR: JOHN LEMKE

SURVEY LOCATION: 5983-5985 CHRISTINE COURT



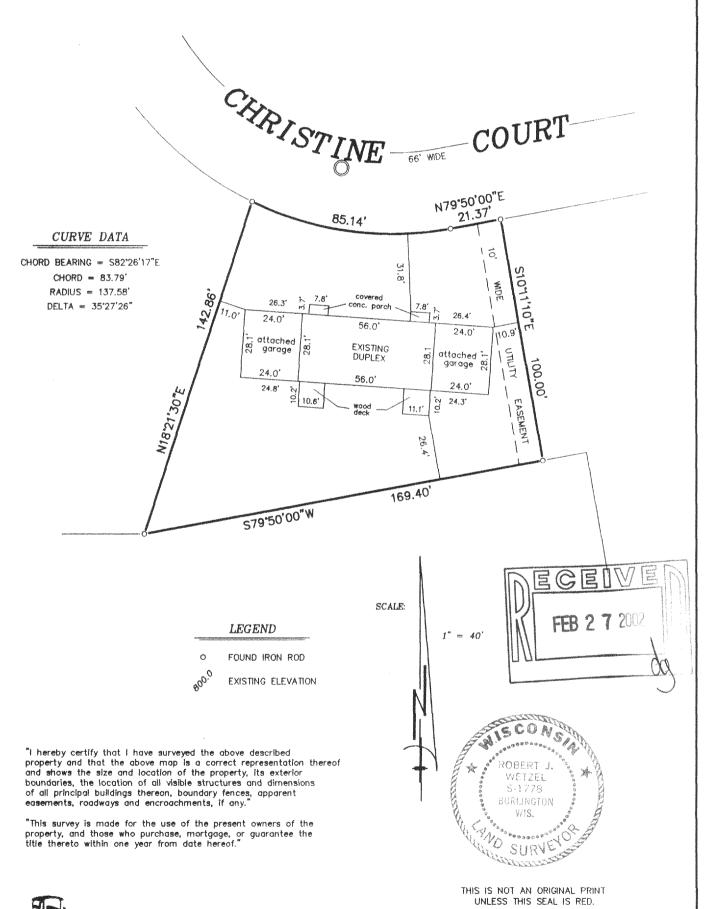

B.W. SURVEYING

412 N. PINE STREET BURLINGTON, WI 53105 (414)-767-0225 ROBERT J. WETZEL

REVISED: SEPTEMBER 21, 2001 JANUARY 10, 2000

DATE

4287-6 JOB NUMBER

S = 1778

REVISED: FEBRUARY 18, 2002

NrH-6 918-1293