
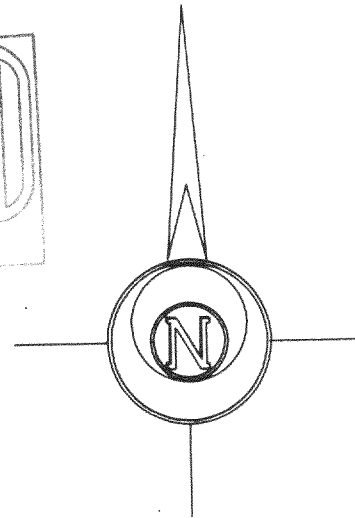


# Plat of Survey

NCS-92



of  
Unit 92 of Phase I of Country Estates,  
a condominium located in the Northwest 1/4 of Section 8, Town 2 North,  
Range 18 East, Town of Lyons, Walworth County, Wisconsin.

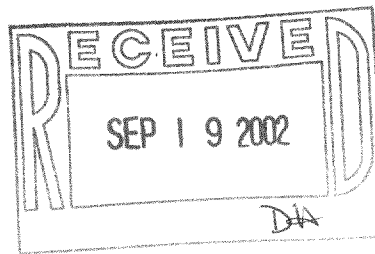

Bearings referenced to the  
plat of Country Estates.

Surveyed for: **Coldwell Banker, Beardsley & Associates**  
598 Milwaukee Avenue  
Burlington, Wisconsin. 53105

\*\* - The location of buried utility lines is shown as  
marked by diggers hotline and may not be correct.

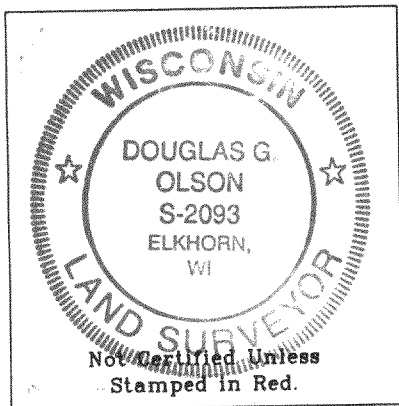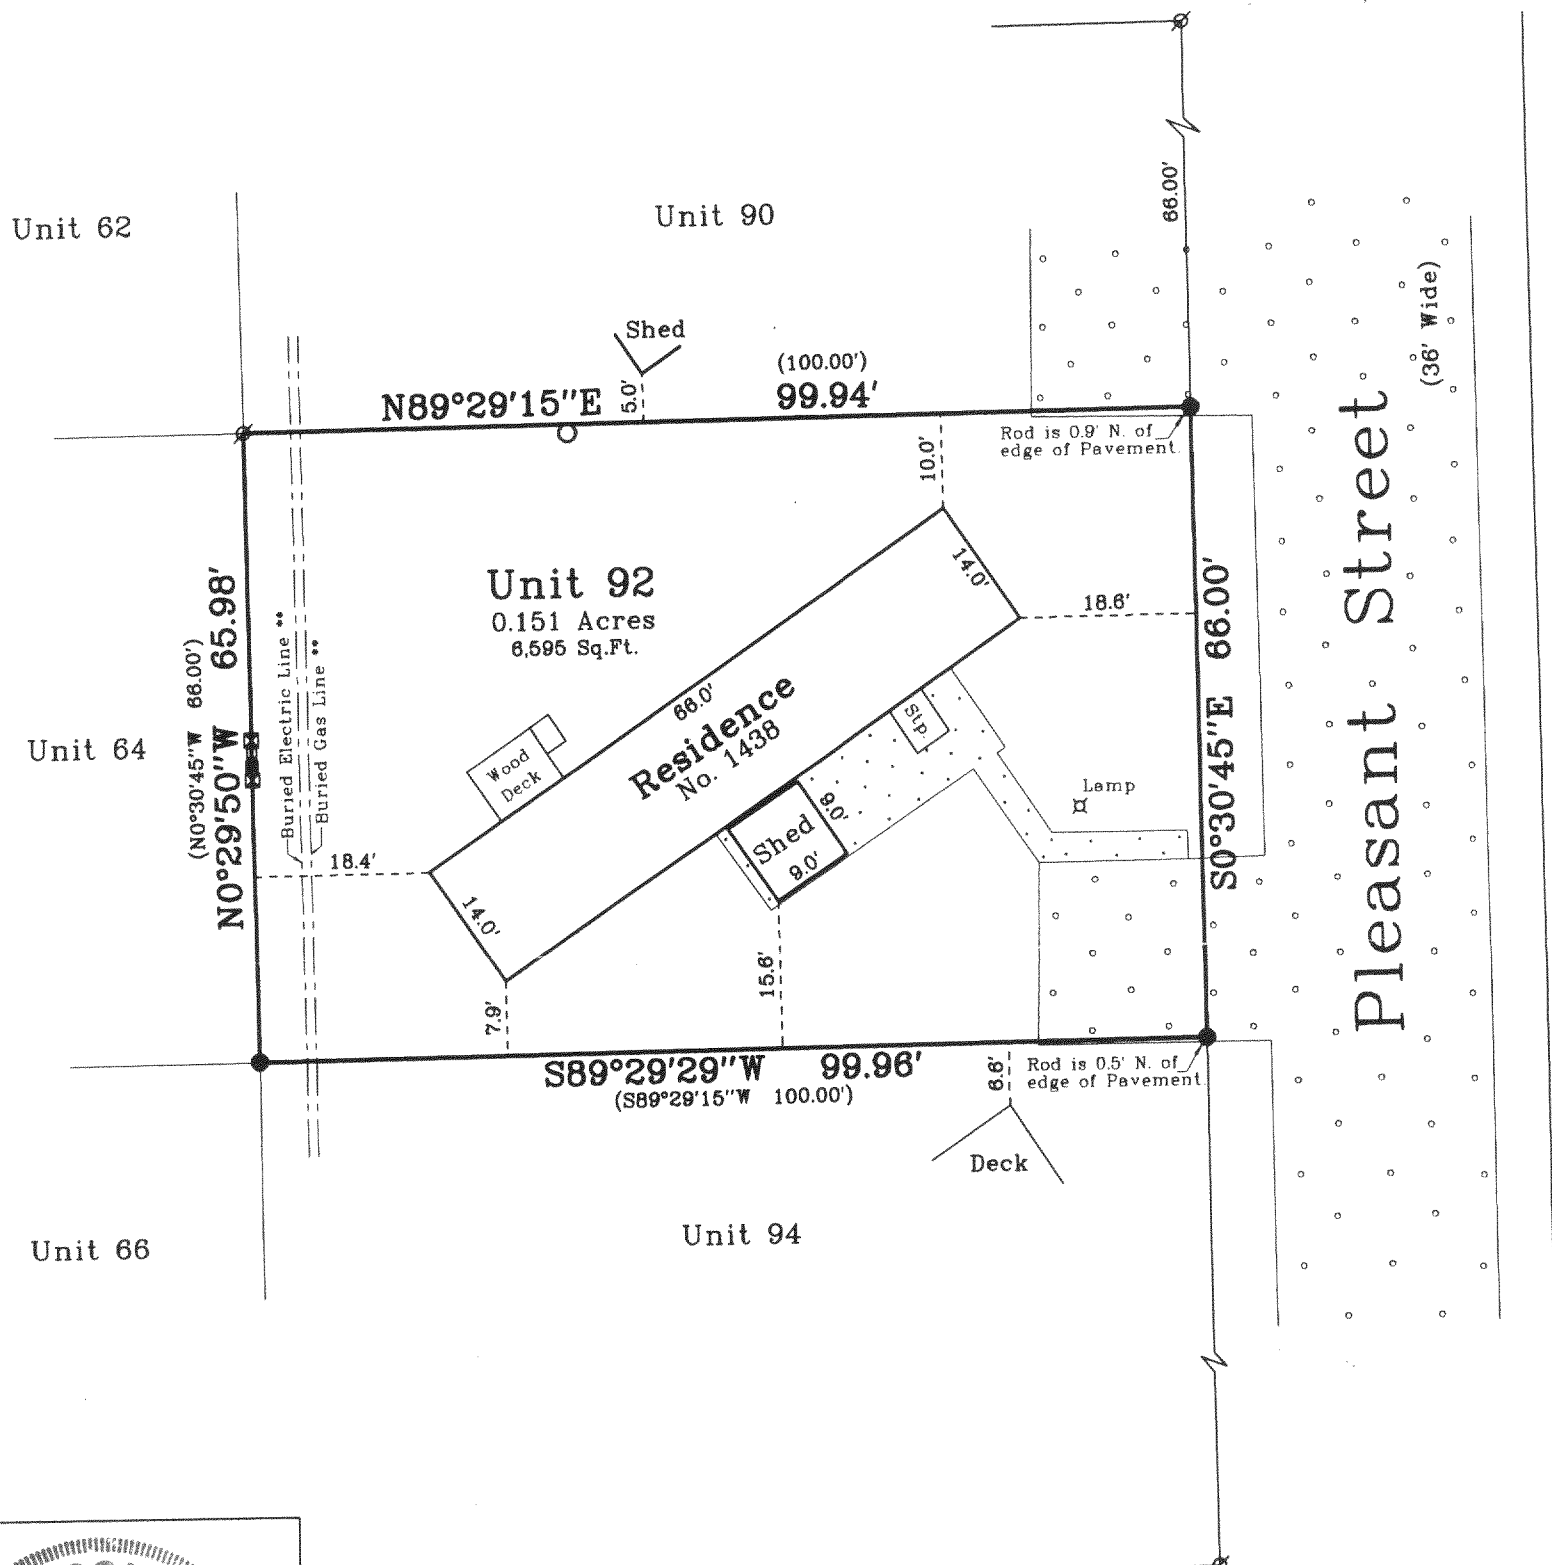

Copyright © 2001 by Jensen & Olson Land Surveying, LLC.

All rights reserved. No part of this survey plat may be reproduced or transmitted in any form by any means - graphic, electronic, or mechanical, including photocopying, tracing, or information storage and retrieval systems - without permission in writing from Douglas G. Olson, Jensen & Olson Land Surveying, LLC.

I hereby certify that I have surveyed the above described property and the map hereon is correct to the best of my professional knowledge and belief and shows the size and location of the property, its exterior boundaries, the location and dimensions of all visible structures thereon, boundary fences, apparent easements and roadways and visible encroachments, if any.  
This survey is made for the exclusive use of the present owners of property, and also those who purchase, mortgage or guarantee title thereto, within one year from the date hereof.

Douglas G. Olson  
Wisconsin Registered Land Surveyor - 2093

## Notes:

- 1) This survey plat is not certified unless signed and sealed in red ink.
- 2) This survey is subject to Wisconsin lien laws. This Plat of Survey is the notice of intent to file lien. Lien waiver required.

## Legend

- Found Iron Pipe
- Set Iron Rod, 3/4" diameter
- ( ) Recorded Information
- Concrete Surface
- Asphalt Surface
- Manhole
- Utility Pedestal
- Electric Panel
- ⊗ Gas Meter

## Jensen & Olson Land Surveying, LLC

45 South Wisconsin Street P.O. Box 322  
Elkhorn, Wisconsin. 53121  
Telephone: (262) 723-3434  
Facsimile: (262) 723-8044

Scale: 1" = 20'



Survey date: August 8, 2001.  
Revisions:

Sheet 1 of 1 Sheets.

Job Reference Number:

2001.110  
218-1325