


DEGEN-FOAT SURVEYING LLC
 100 SOUTH SECOND STREET
 WATERFORD, WISCONSIN
 (262)534-5404 (FAX)534-2022

037034
 037034S1.DWG

PLAT OF SURVEY

LOT 4, BLOCK 7, BURKE AND CAMPBELL'S VILLAGE OF LYONS,
 LOCATED IN THE TOWNSHIP OF LYONS, WALWORTH COUNTY, WISCONSIN.

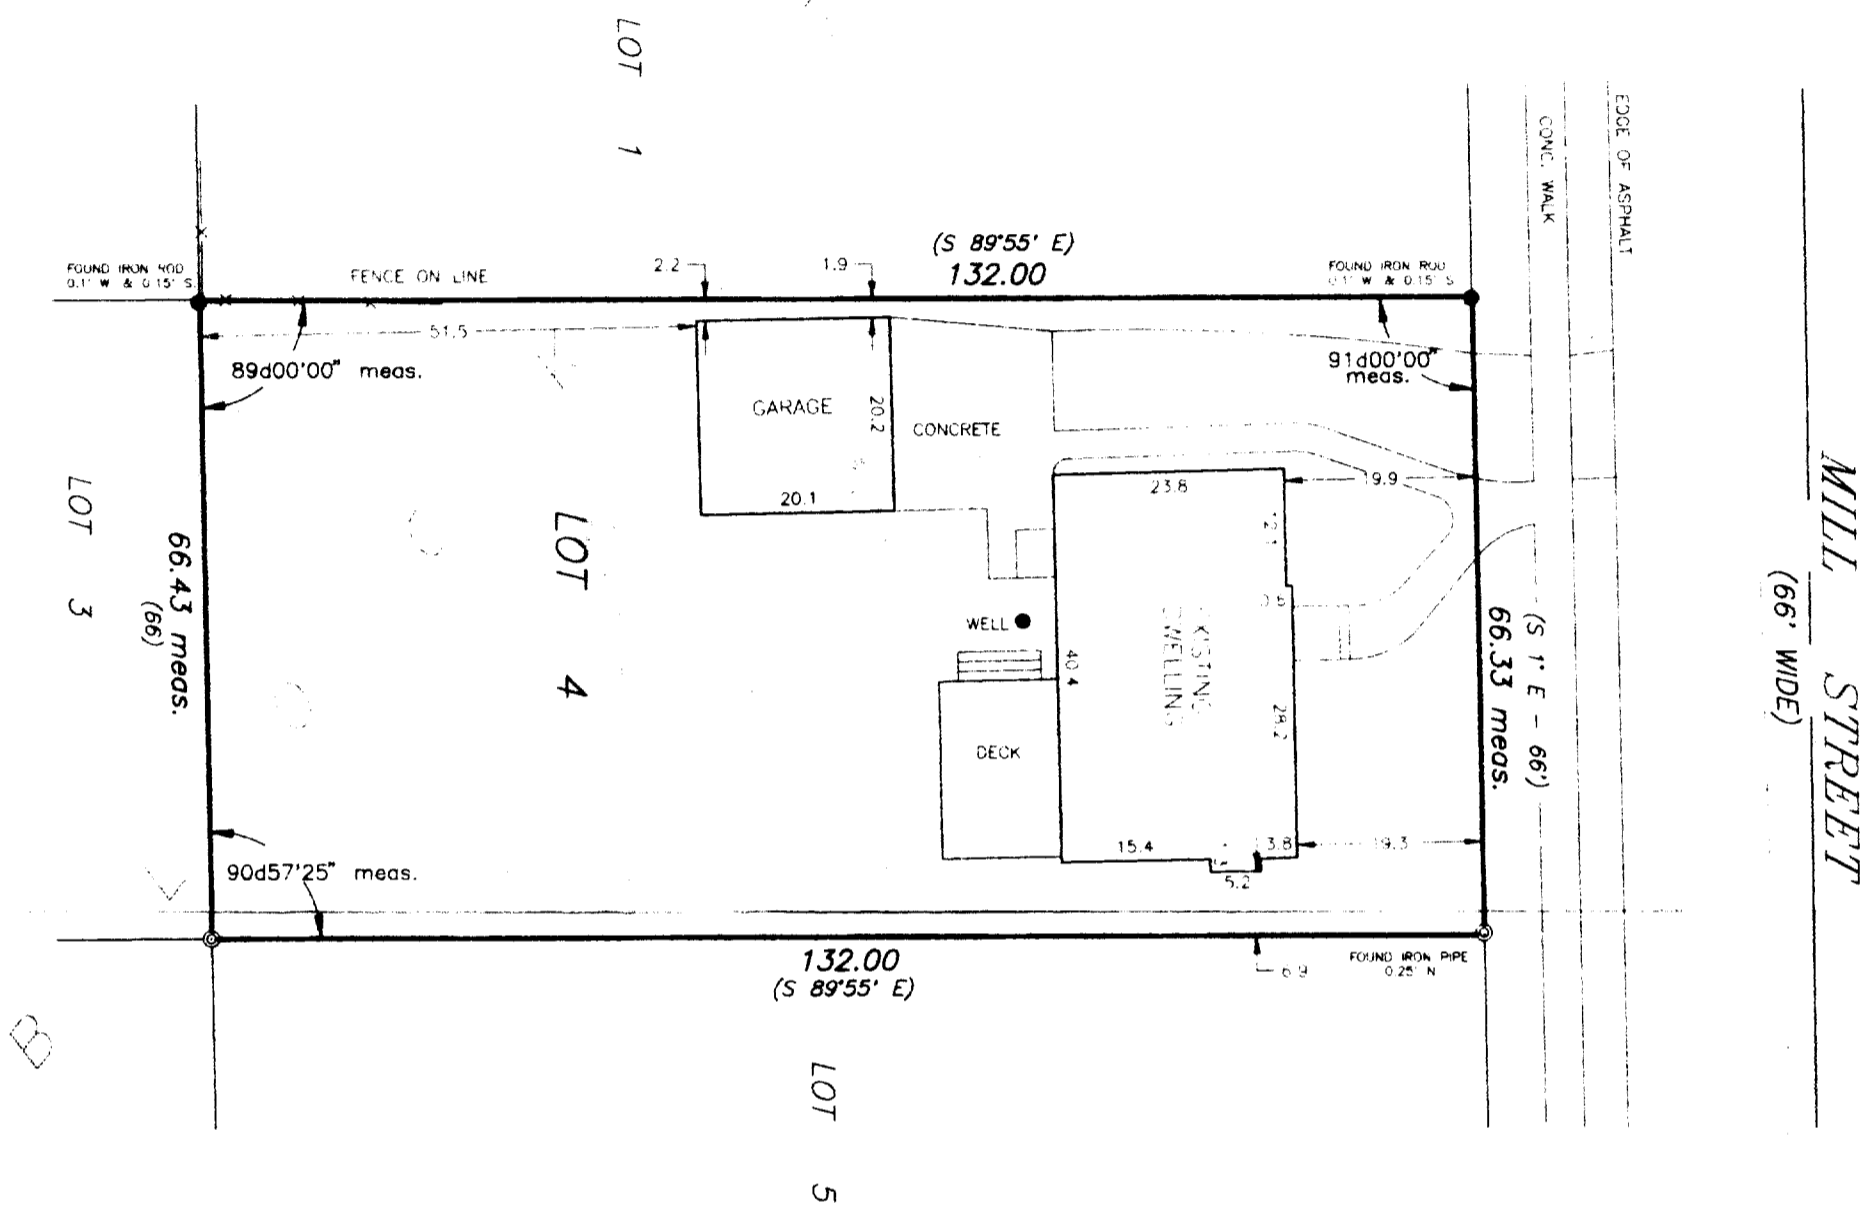


PREPARED FOR: KURT & DIANA ROBERS
 1512 MILL STREET
 LYONS, WI 53148

LEGEND

- ⊙ - FOUND IRON PIPE
- - FOUND IRON ROD
- - SET IRON PIPE
- - WOOD FENCE
- () - RECORDED AS

SCALE: 1" = 20'

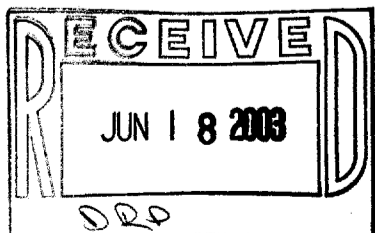

I HEREBY CERTIFY THAT I HAVE SURVEYED THE ABOVE DESCRIBED PROPERTY AND THE ABOVE MAP IS A TRUE REPRESENTATION THEREOF AND SHOWS THE SIZE AND LOCATION OF THE PROPERTY, THE LOCATION OF ALL VISIBLE STRUCTURES AND DIMENSIONS OF ALL PRINCIPAL BUILDINGS THEREON, BOUNDARY FENCES, APPARENT EASEMENTS, ROADWAY AND VISIBLE ENCROACHMENTS, IF ANY.

THIS SURVEY IS MADE FOR THE PRESENT OWNERS OF THE PROPERTY, AND ALSO THOSE WHO PURCHASE, OR GUARANTEE THE TITLE THERETO WITHIN (1) YEAR FROM THE DATE HEREOF.

DATED AT WATERFORD THIS 7TH DAY OF FEBRUARY 20 03

RECERTIFIED _____

Gary B. Foat

NL-49

218-1383