



PREPARED FOR :
JILL JENSEN
1613 VICTORIA DR.
WAUKESHA, WI. 53189

PLAT OF SURVEY

J.K. SURVEYING INC.
N3705 WILLOWBEND LANE
LAKE GENEVA, WI, 53147
262-248-3697

OF

UNIT 9 OF COUNTRY ESTATES A CONDOMINIUM, LOCATED IN SECTIONS 7 AND 8, TOWN 2 NORTH. RANGE 18 EAST, WALWORTH COUNTY, WISCONSIN.

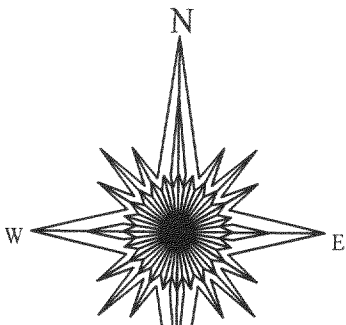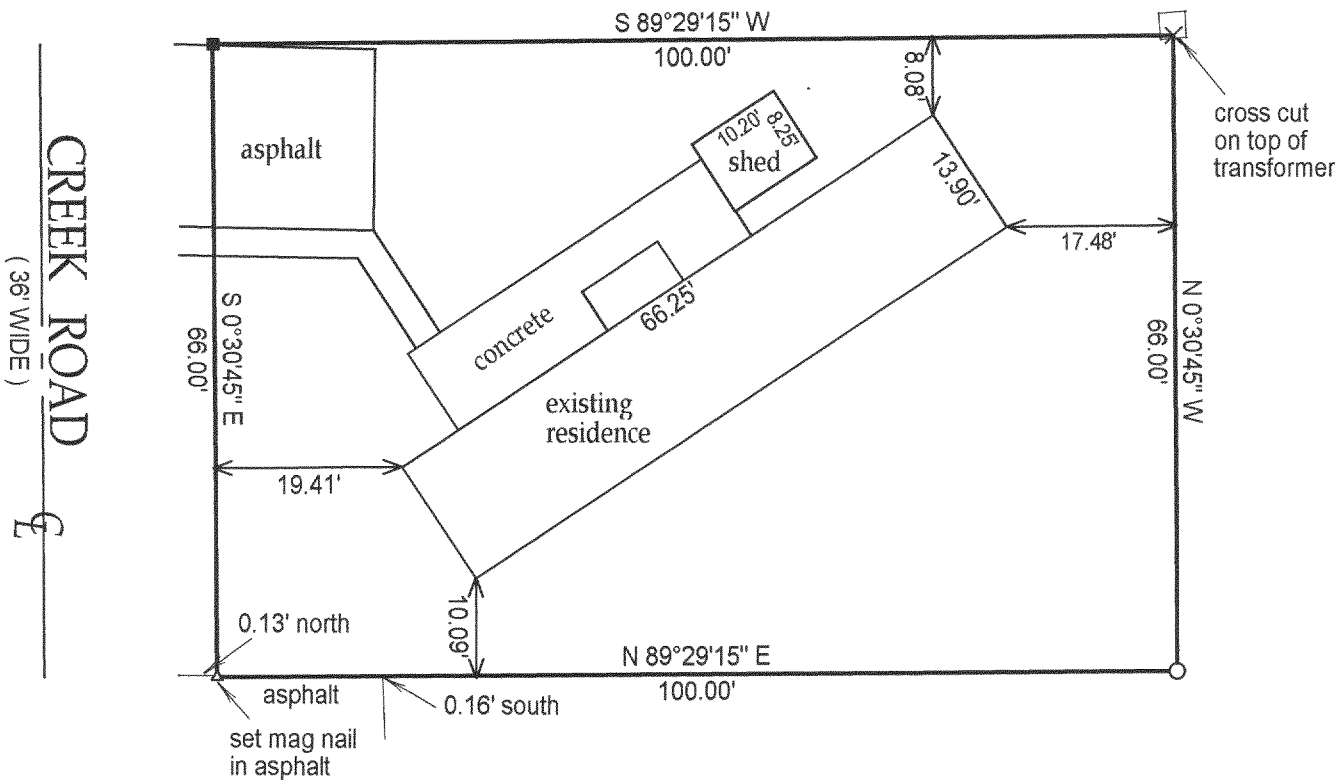

- () = recorded as
■ = set iron bar
□ = found iron bar
○ = found iron pipe
● = set iron pipe

COMPARE LEGAL DESCRIPTION ABOVE AND DRAWING WITH DEED. FOR BUILDING RESTRICTIONS AND EASEMENTS NOT SHOWN, REFER TO DEED, ABSTRACT SOURCES AND LOCAL MUNICIPAL CODES. NOTIFY THE SURVEYOR IMMEDIATELY OF ANY DISCREPANCY.

"I hereby certify that I have surveyed the above described property and that the above map is a true representation thereof and shows the size and location of all visible structures, apparent easements and encroachments if any."

This survey is made for the present owners of the property, and those who purchase, mortgage, or guarantee the title thereto, within one year from the date hereof.

JOB# 03-304

SCALE: 1"=20'

TAX KEY #

NCS 00009

DATED THIS 27 TH DAY OF MAY 2003

JEFFREY L KIMPS S-2436
Wisconsin Registered Land Surveyor
(original if signed in red)

218-1406