


# Plat of Survey

of

A parcel of land described in a Quit Claim Deed recorded in Vol. 678 on Page 4433 as Document No. 465466 as shown below:  
A parcel of land being part of Lots 1, 3 and 4, Block 14, of the Plat of Springfield, described as follows: Beginning at the Northeast corner of said Lot 1, thence South along the Easterly line of Lots 1, 3 and 4 a distance of 151.00 feet; thence West 40.00 feet; thence N 13°58'05" W. 30.00 feet; thence S 79°46'45" W. 15.00 feet; thence N 12°39'20" W. 110.97 feet to the Northerly line of said Lot 1; thence N 74°44'15" E. 70.00 feet; thence S 83°27'25" E. 18.91 feet to the place of beginning.

Surveyed for: **Russ Lineck**  
W2566 Hospital Road  
Elkhorn, Wisconsin. 53121

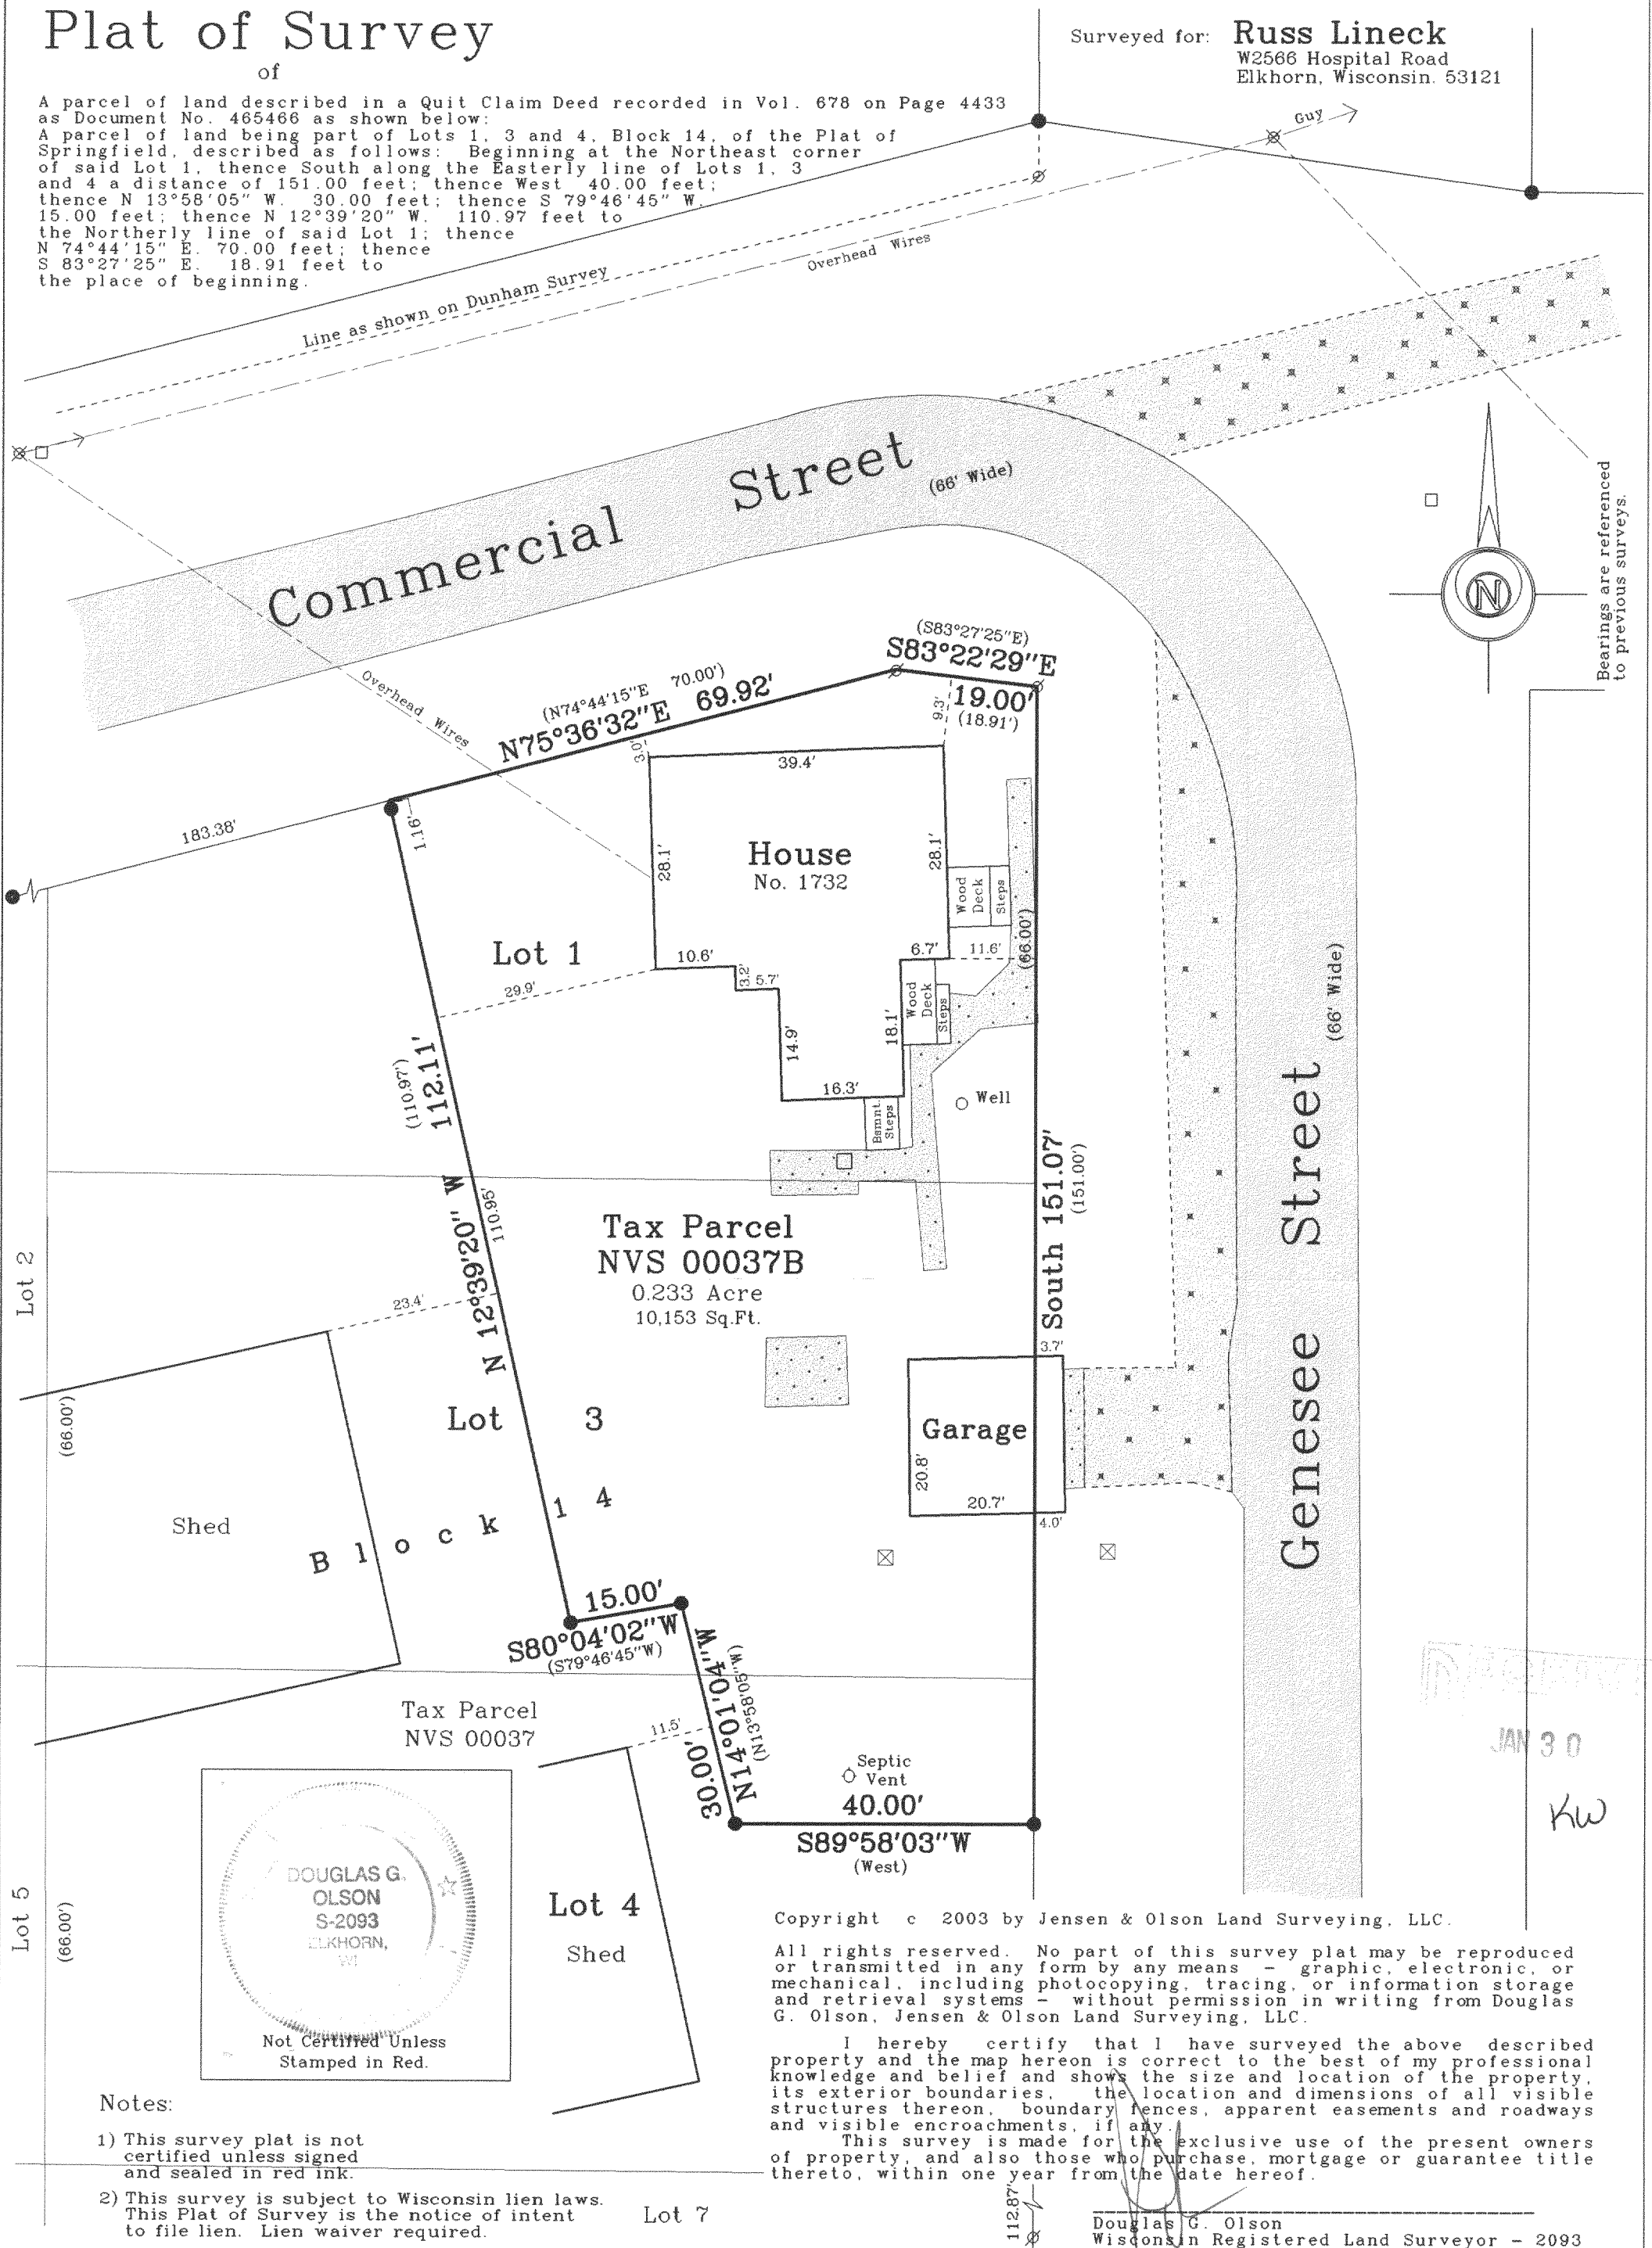

Bearings are referenced to previous surveys.

RECEIVED  
JAN 30

KW

Copyright © 2003 by Jensen & Olson Land Surveying, LLC.

All rights reserved. No part of this survey plat may be reproduced or transmitted in any form by any means - graphic, electronic, or mechanical, including photocopying, tracing, or information storage and retrieval systems - without permission in writing from Douglas G. Olson, Jensen & Olson Land Surveying, LLC.

I hereby certify that I have surveyed the above described property and the map hereon is correct to the best of my professional knowledge and belief and shows the size and location of the property, its exterior boundaries, the location and dimensions of all visible structures thereon, boundary fences, apparent easements and roadways and visible encroachments, if any.  
This survey is made for the exclusive use of the present owners of property, and also those who purchase, mortgage or guarantee title thereto, within one year from the date hereof.

Douglas G. Olson  
Wisconsin Registered Land Surveyor - 2093

## Notes:

- 1) This survey plat is not certified unless signed and sealed in red ink.
- 2) This survey is subject to Wisconsin lien laws. This Plat of Survey is the notice of intent to file lien. Lien waiver required.

Lot 7

## Legend

- Found Iron Pipe
- Found Iron Rod
- Recorded Information
- Concrete Cover
- Utility Pole
- Utility Pedestal
- Concrete Surface
- Asphalt Surface
- Gravel Surface

## Jensen & Olson Land Surveying, LLC

45 South Wisconsin Street P.O. Box 322  
Elkhorn, Wisconsin. 53121  
Telephone: (262) 723-3434  
Facsimile: (262) 723-8044

Scale: 1" = 20'



Survey date: December 8, 2003.  
Revisions:

Sheet 1 of 1 Sheets.

Job Reference Number:

2003.203

NVS-37B

218-1434