PLAT OF SURVEY -OF-

LOT 25 OF TUSCANY OF LAKE GENEVA, PHASE 2, LOCATED IN THE SOUTHEAST 1/4 OF THE SOUTHWEST 1/4 AND THE NORTHEAST 1/4 OF THE SOUTHWEST 1/4 OF SECTION 34, TOWNSHIP 2 NORTH, RANGE 18 EAST AND THE NORTHEAST 1/4 OF THE NORTHWEST 1/4 OF SECTION 3, TOWNSHIP 1 NORTH, RANGE 18 EAST, WALWORTH COUNTY, WISCONSIN.

SURVEY FOR: KERKMAN BROTHERS CONSTRUCTION

SURVEY ADDRESS: 3390 VIA CASSIO


I HEREBY CERTIFY THAT THE EXISTING FOUNDATION SHOWN ON THIS PLAT OF SURVEY IS LOCATED AS SHOWN THUS (), DATED THIS 11TH DAY OF NOVEMBER, 2004.

FRANKLIN J. LEHMAN S-2211

EXISTING TOP OF FOUNDATION: 871.7'

DETAIL

SCALE: 1" = 30'

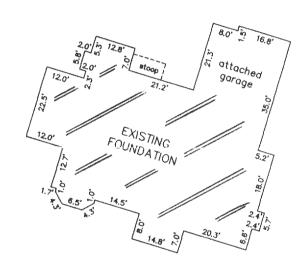

LEGEND

- FOUND 2" DIA. IRON PIPE
- O FOUND 1" DIA. IRON PIPE
- Ø FOUND 3/4" DIA. IRON ROD
- SET 1" DIA. IRON PIPE
- & EXISTING ELEVATION


"I hereby certify that I have surveyed the above described property and that the above map is a correct representation thereof and shows the size and location of the property, its exterior boundaries, the location of all visible structures and dimensions of all principal buildings thereon, boundary fences, apparent easements, roadways and encroachments, if any."

"This survey is made for the use of the present owners of the property, and those who purchase, mortgage, or guarantee the title thereto within one year from date hereof."



B.W. SURVEYING, INC.

LAND SURVEYS
MAPPING AND PLANNING
412 N. PINE STREET
BURLINGTON, WI 53105
(262)-767-0225

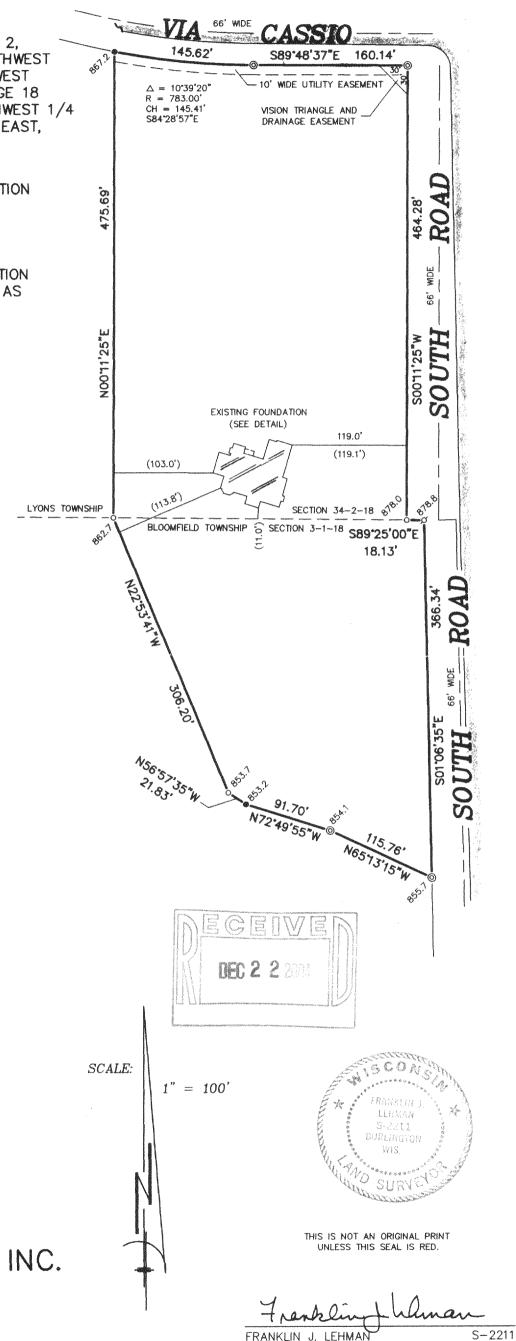

AUGUST 17, 2004

DATE

NTU2-1 MTU2-1 6518 JOB NUMBER