



PREPARED FOR:  
FRED GELDERMAN  
COLDWELL BANKER PRIMUS

PLAT OF SURVEY

J.K. SURVEYING INC.  
N3705 WILLOWBEND LANE  
LAKE GENEVA, WI 53147  
(262) 248-3697

-OF-  
LOT 1 OF CERTIFIED SURVEY MAP NUMBER 964, LOCATED IN SOUTHEAST  
1/4 OF THE NORTHWEST 1/4 OF SECTION 30, TOWN 2 NORTH, RANGE 18  
EAST, TOWN OF LYONS, WALWORTH COUNTY, WISCONSIN.

SHERIDAN SPRINGS ROAD  
(100' WIDE)

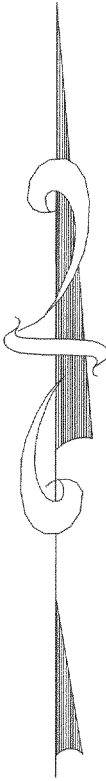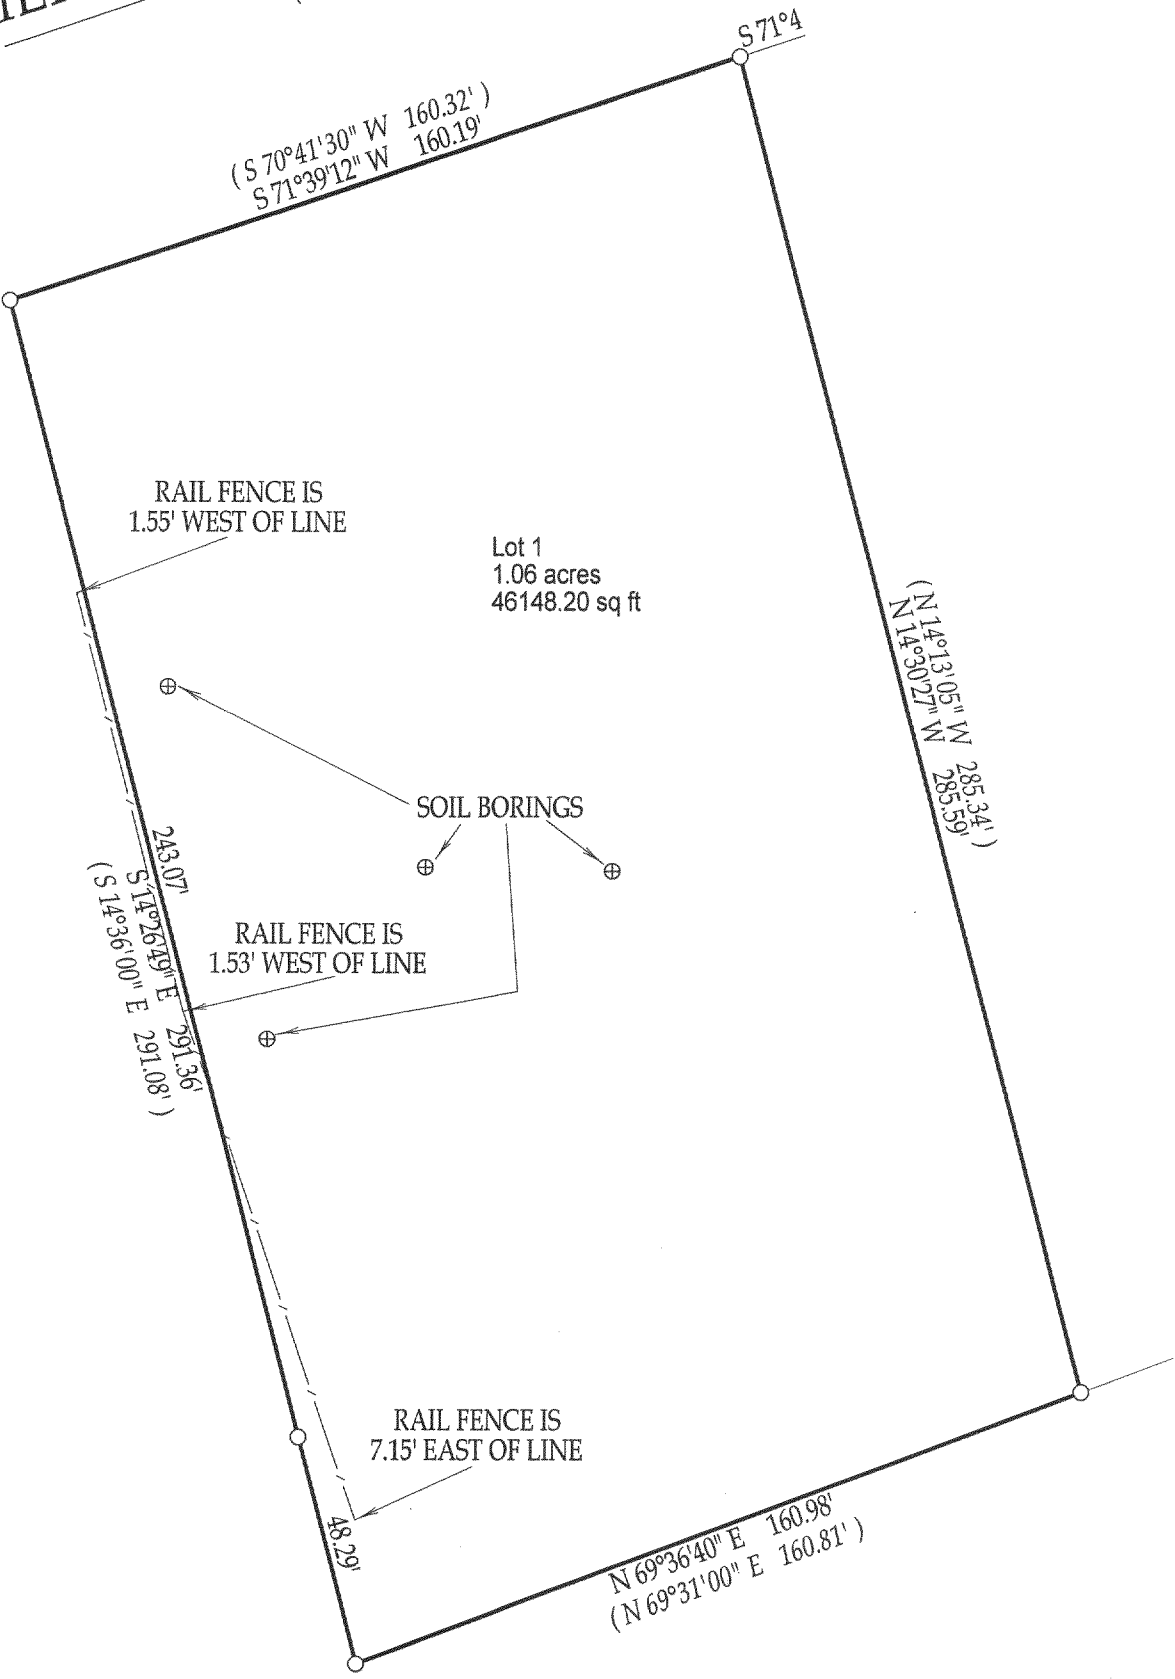

- ( ) = RECORDED AS
- = FOUND IRON BAR
- = FOUND IRON PIPE
- = SET IRON PIPE
- = SET IRON BAR

SCALE: 1" = 40'

JOB #: 04-518C


TAX ID #: NA 96400001

NOTE: BASIS OF BEARING IS DOCUMENT NUMBER 51047

COMPARE LEGAL DESCRIPTION ABOVE AND DRAWING WITH DEED. FOR BUILDING RESTRICTIONS AND EASEMENTS NOT SHOWN, REFER TO DEED, ABSTRACT SOURCES AND LOCAL MUNICIPAL CODES. NOTIFY THE SURVEYOR IMMEDIATELY OF ANY DISCREPANCY.

"I hereby certify that the above described property was surveyed under my supervision and that the above map, to the best of my knowledge and belief, is a true representation thereof and shows the size and location of all visible structures, apparent easements and encroachments if any."  
This survey is made for the present owners of the property, and those who purchase, mortgage, or guarantee the title thereto, within one year from the date hereof.

FEB 18 2005

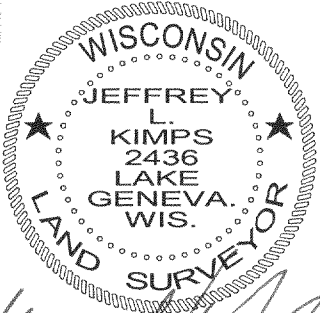

JEFFREY L. KIMPS 8-2436  
Wisconsin Registered Land Surveyor  
(original if signed in red)

DATED THIS 5th DAY OF OCTOBER, 2004