


**-OF-**


SURVEY FOR: KEVIN RUTKOWSKI

PROPOSED ADDRESS: \_\_\_\_\_ GAIL LYNNE TRACE

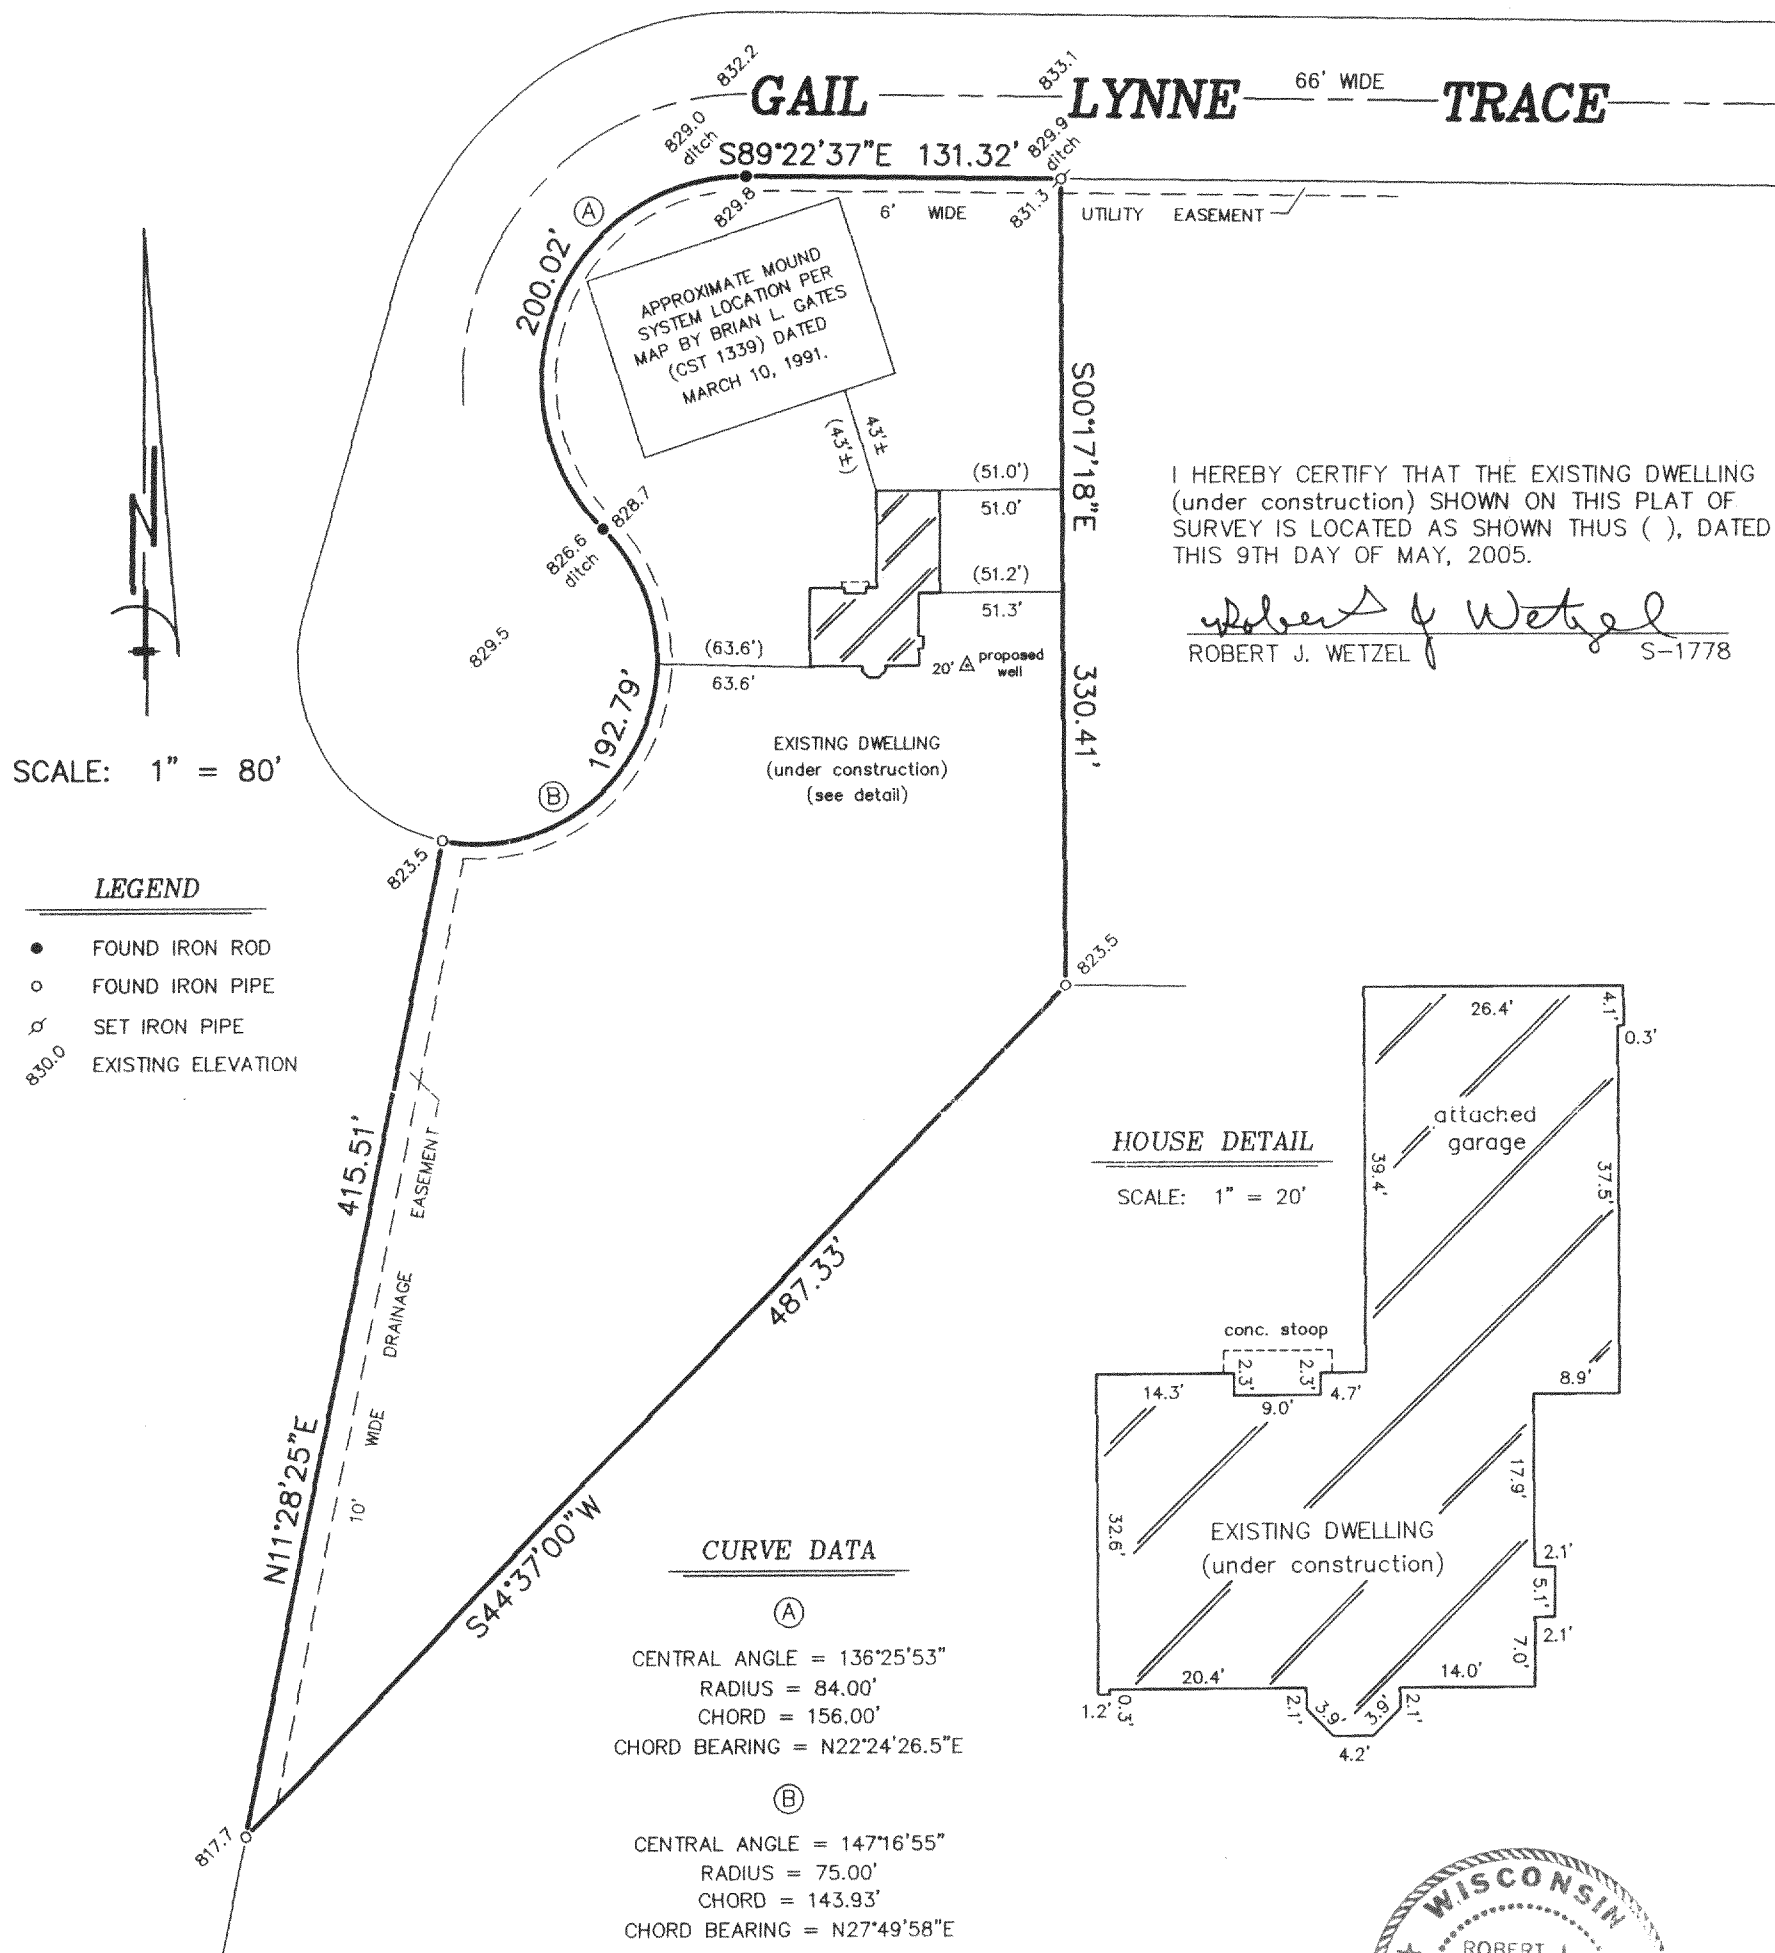

"I hereby certify that I have surveyed the above described property and that the above map is a correct representation thereof and shows the size and location of the property, its exterior boundaries, the location of all visible structures and dimensions of all principal buildings thereon, boundary fences, apparent easements, roadways and encroachments, if any."

"This survey is made for the use of the present owners of the property, and those who purchase, mortgage, or guarantee the title thereto within one year from date hereof."

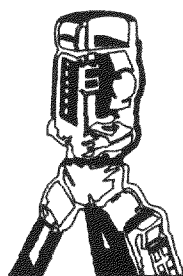

B.W. SURVEYING, INC.

LAND SURVEYS  
MAPPING AND PLANNING  
412 N. PINE STREET  
BURLINGTON, WI 53105  
(262)-767-0225

THIS IS NOT AN ORIGINAL PRINT  
UNLESS THIS SEAL IS RED.

ROBERT J. WETZEL  
5-1778  
MSD: MARCH 16, 2005

REVISED: MARCH 16, 2005  
MARCH 14, 2005  
 DATE

6745  
JOB NUMBER

NZA 0009

218-1528