



PREPARED FOR:
 CHERYL HANSEN
 REMAX GENEVA REALTY
 101 BROAD ST, SUITE 102
 LAKE GENEVA, WI, 53147

PLAT OF SURVEY


-OF-

LOT 22 OF LYONS HILLSIDE SUBDIVISION, A SUBDIVISION LOCATED
 IN PART OF THE NORTHWEST 1/4 OF THE SOUTHEAST 1/4 OF
 SECTION 10, TOWN 2 NORTH, RANGE 18 EAST, TOWN OF LYONS,
 COUNTY OF WALWORTH, STATE OF WISCONSIN.

PATHFINDER SURVEYING INC.
 W2888 KRUEGER ROAD, UNIT "D"
 LAKE GENEVA, WI, 53147
 262-248-3697

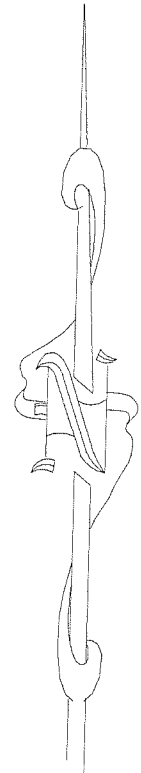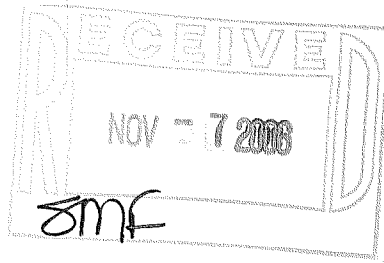

CHRISTINE COURT
 (66' WIDE)

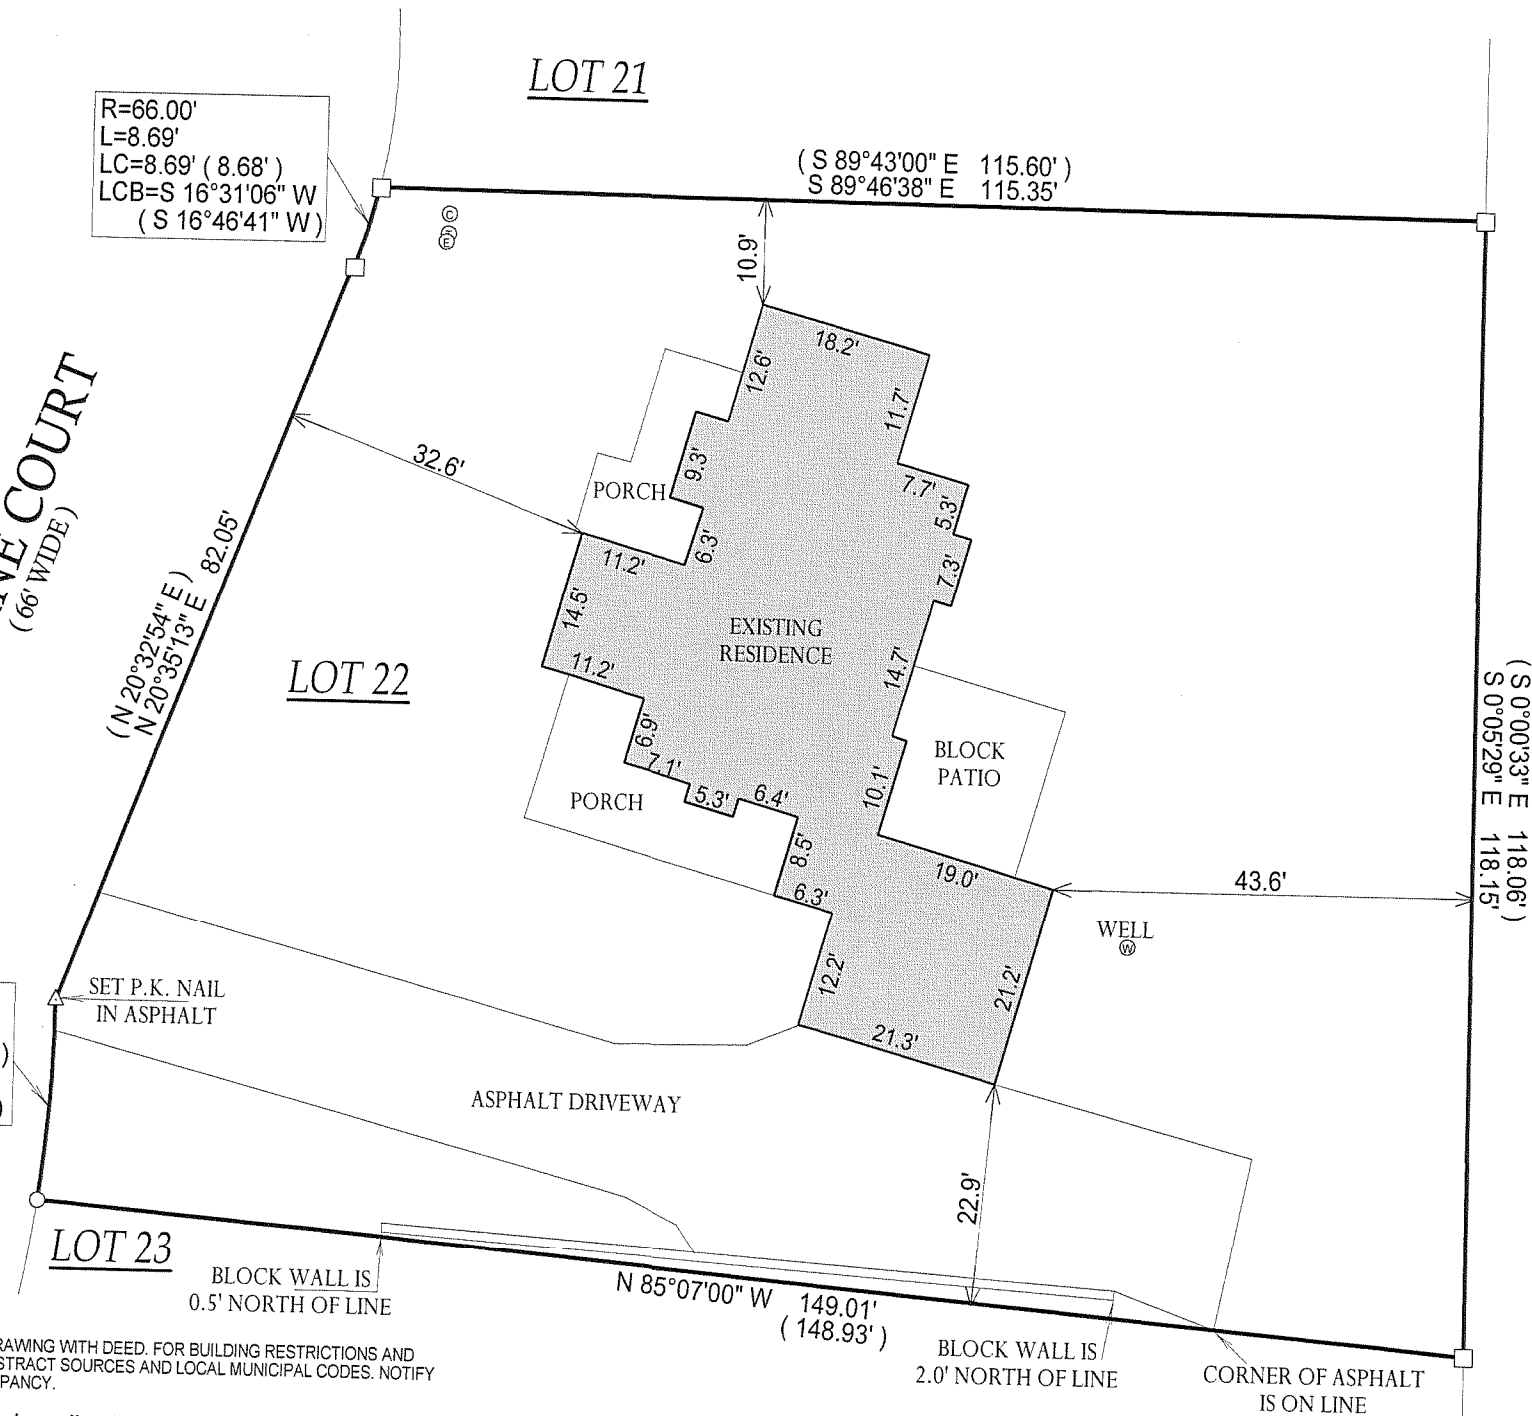

R=66.00'
 L=8.69'
 LC=8.69' (8.68')
 LCB=S 16°31'06" W
 (S 16°46'41" W)

R=150.99'
 L=20.89' (20.88')
 LC=20.87' (20.86')
 LCB=N 3°52'53" E
 (N 3°57'40" E)


- ⓔ = ELECTRICAL PEDESTAL
- Ⓣ = TELEPHONE PEDESTAL
- ⓐ = CABLE PEDESTAL
- () = RECORDED AS
- = FOUND IRON BAR
- = FOUND IRON PIPE
- = SET IRON PIPE
- = SET IRON BAR

COMPARE LEGAL DESCRIPTION ABOVE AND DRAWING WITH DEED. FOR BUILDING RESTRICTIONS AND EASEMENTS NOT SHOWN, REFER TO DEED, ABSTRACT SOURCES AND LOCAL MUNICIPAL CODES. NOTIFY THE SURVEYOR IMMEDIATELY OF ANY DISCREPANCY.

"I hereby certify that the above described property was surveyed under my supervision and that the above map, to the best of my knowledge and belief, is a true representation thereof and shows the size and location of all visible structures, apparent easements and encroachments if any." This survey is made for the present owners of the property, and those who purchase, mortgage, or guarantee the title thereto, within one year from the date hereof.

NOTE: BASIS OF BEARING IS RECORD PLAT.

DATED THE 7th DAY OF SEPTEMBER, 2006.

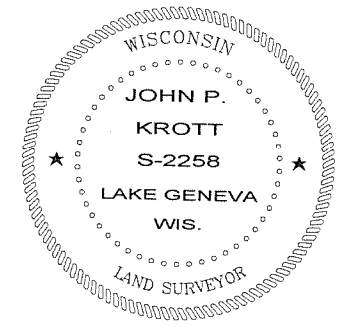

John P. Krott
 JOHN KROTT S - 2258
 Wisconsin Registered Land Surveyor
 (original if signed in red)

SCALE: 1" = 20'
 JOB #: 06-433
 TAX ID #: NLH 00022

218-1602