


Plat of Survey




of
Unit 92 of Phase I of Country Estates,
a condominium located in the Northwest 1/4 of Section 8, Town 2 North,
Range 18 East, Town of Lyons, Walworth County, Wisconsin.

Surveyed for: **Harlan Hudson**
1438 Pleasant Street
Burlington, Wisconsin. 53105

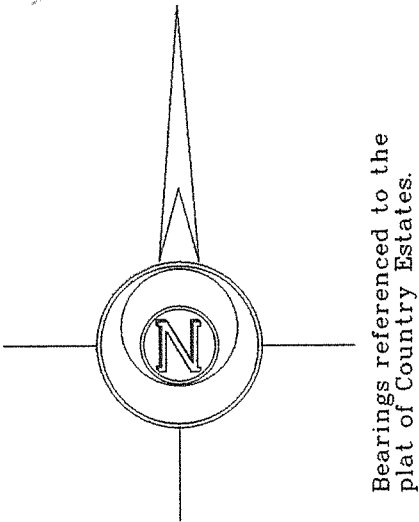

Note: Vinyl siding not included in the New Residence dimensions or the distances to the property lines.

** - The location of buried utility lines is shown as shown on a prior survey dated August 8, 2001 as marked by diggers hotline and may not be correct.

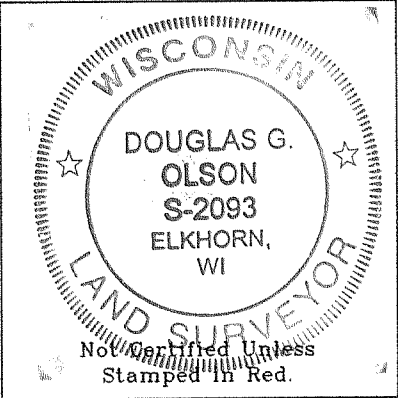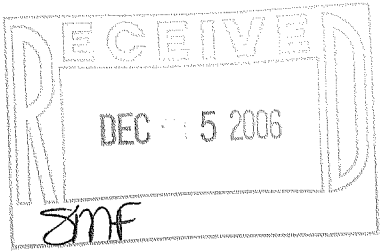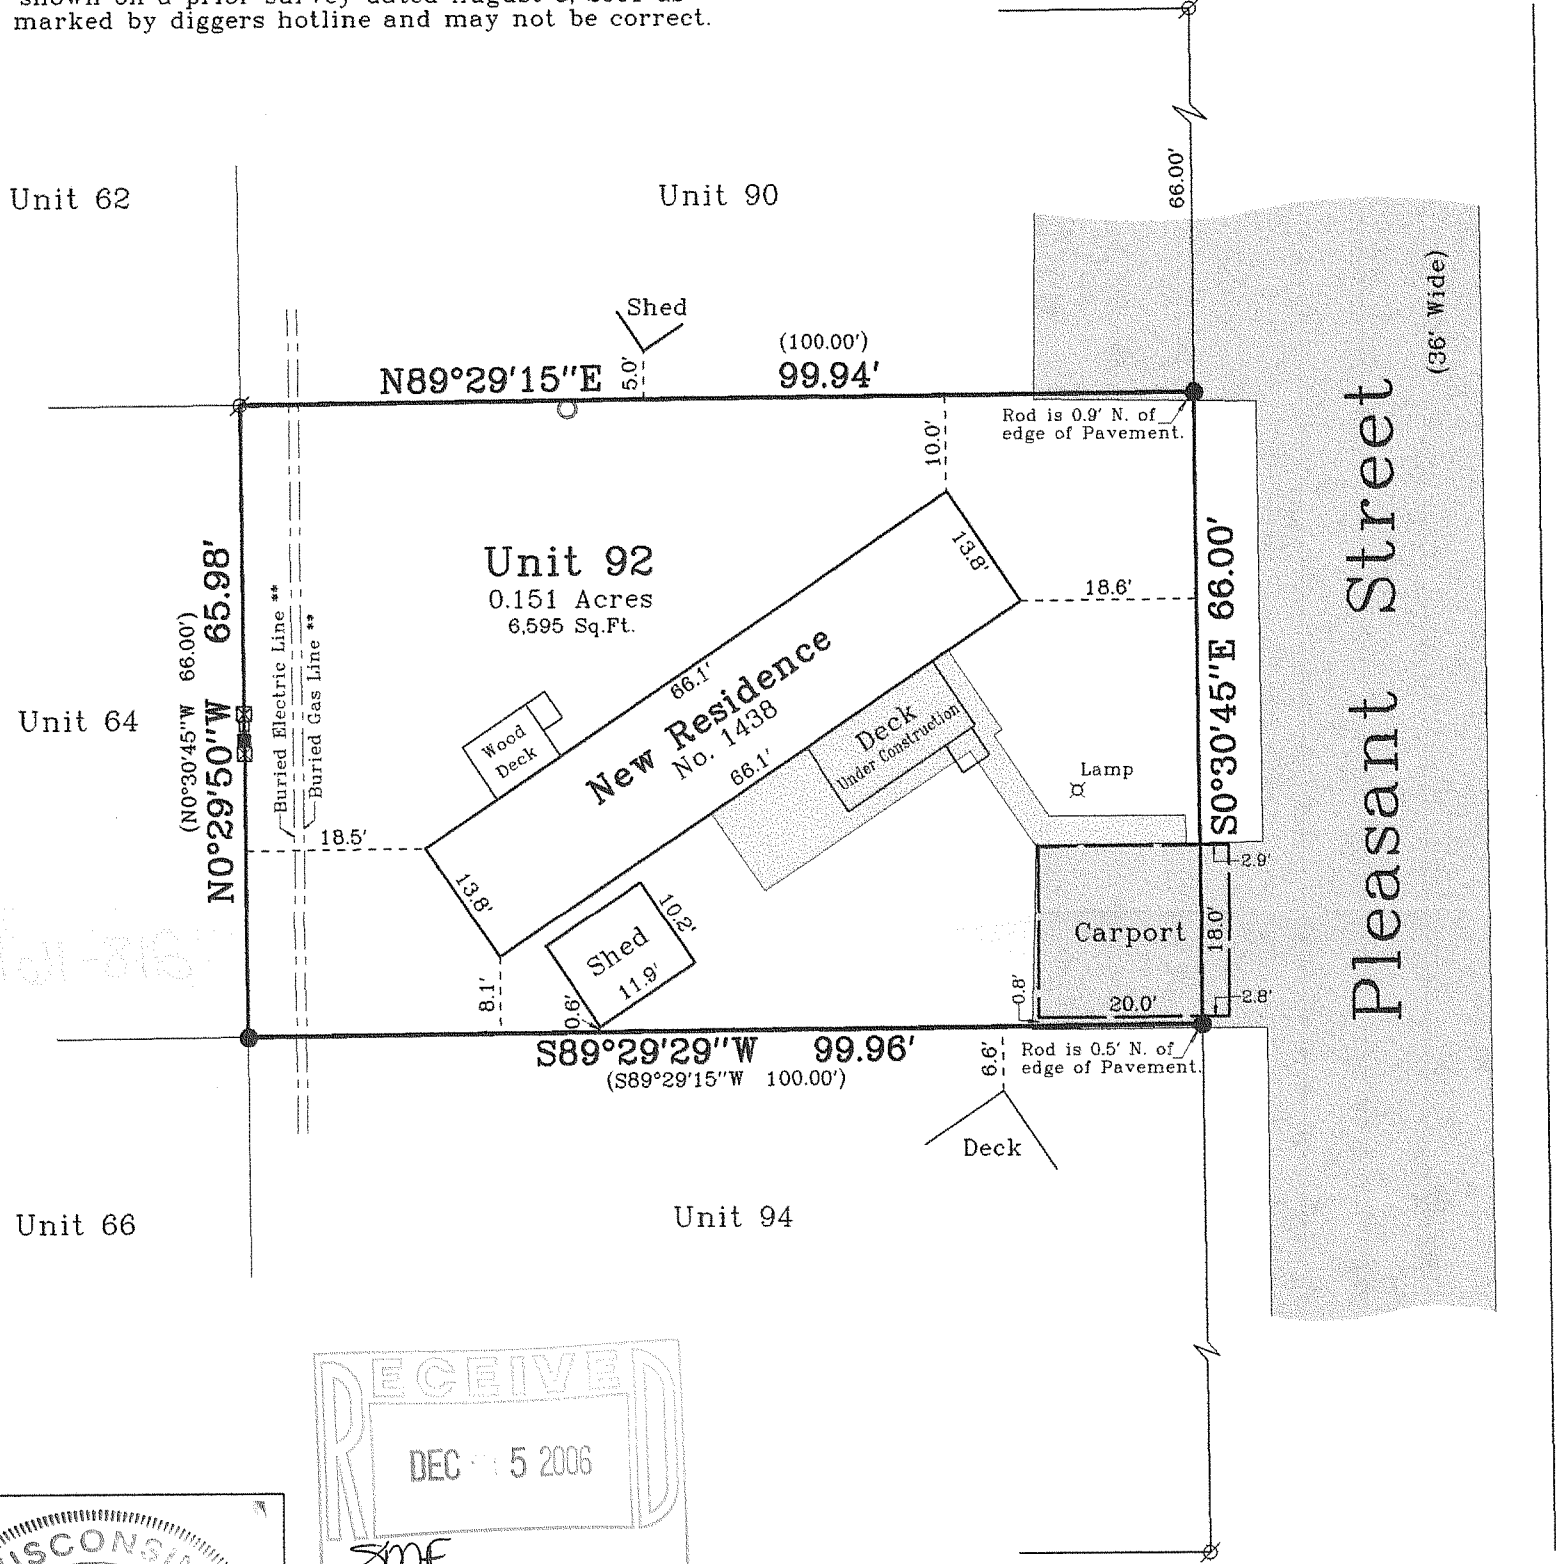

Copyright c 2006 by Jensen & Olson Land Surveying, LLC.

All rights reserved. No part of this survey plat may be reproduced or transmitted in any form by any means - graphic, electronic, or mechanical, including photocopying, tracing, or information storage and retrieval systems - without permission in writing from Douglas G. Olson, Jensen & Olson Land Surveying, LLC.

I hereby certify that I have surveyed the above described property and the map hereon is correct to the best of my professional knowledge and belief and shows the size and location of the property, its exterior boundaries, the location and dimensions of all visible structures thereon, boundary fences, apparent easements and roadways and visible encroachments, if any.
This survey is made for the exclusive use of the present owners of property, and also those who purchase, mortgage or guarantee title thereto, within one year from the date hereof.

Douglas G. Olson
Wisconsin Registered Land Surveyor - 2093

- Notes:
- 1) This survey plat is not certified unless signed and sealed in red ink.
 - 2) This survey is subject to Wisconsin lien laws. This Plat of Survey is the notice of intent to file lien. Lien waiver required.

- Legend
- Found Iron Pipe
 - Found Iron Rod
 - () Recorded Information
 - Concrete Surface
 - Asphalt Surface
 - Manhole
 - Utility Pedestal
 - Electric Panel
 - Gas Meter



Jensen & Olson Land Surveying, LLC

45 South Wisconsin Street P.O. Box 322
Elkhorn, Wisconsin. 53121
Telephone: (262) 723-3434
Facsimile: (262) 723-8044

Scale: 1" = 20'



Survey date: July 11, 2006.
Revisions:

Sheet 1 of 1 Sheets.

Job Reference Number:

NCS-92

218-1612 2006.078