
PLAT OF SURVEY -OF-

LOT 4 OF PARTRIDGE WOODS, A SUBDIVISION LOCATED IN SECTION 23, TOWN 2 NORTH, RANGE 18 EAST, TOWN OF LYONS, WALWORTH COUNTY, WISCONSIN.

SURVEY FOR: BART & CAROL KOCHA

SURVEY ADDRESS: 2420 PARTRIDGE WOODS CT.

The state of the s

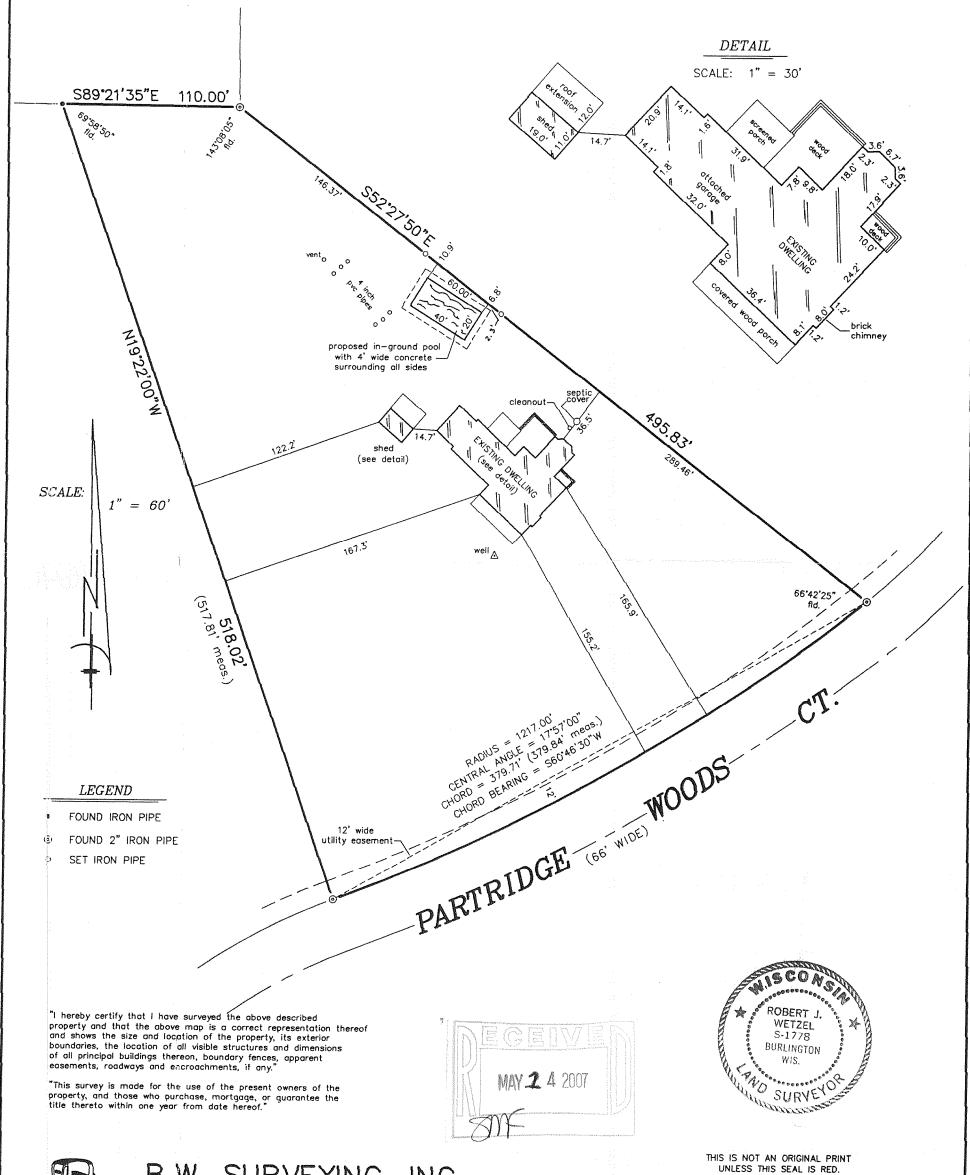



B.W. SURVEYING, INC.

LAND SURVEYS
MAPPING AND PLANNING
412 N. PINE STREET
BURLINGTON, WI 53105
(262)-767-0225

ROBERT J. WETZEL S-

APRIL 24, 2007

DATE

7565a JOB NUMBER

NPRW-4

218-1640