

LAND-MARK SURVEYING


Mark L. Miritz

Wisconsin Registered Land Surveyor S-2582

N9330 Knuteson Drive
Whitewater, WI 53190
Phone: (262) 495-3284
FAX : (262) 495-8421
LAND-MARKSURVEYING.COM


PLAT OF SURVEY

LOT 4 OF THE FIRST ADDITION TO HEATHERIDGE,
A SUBDIVISION LOCATED IN THE NORTH 1/2 OF
THE SOUTHWEST 1/4 OF SECTION 18, TOWN 2
NORTH, RANGE 18 EAST, LYONS TOWNSHIP,
WALWORTH COUNTY, WISCONSIN.

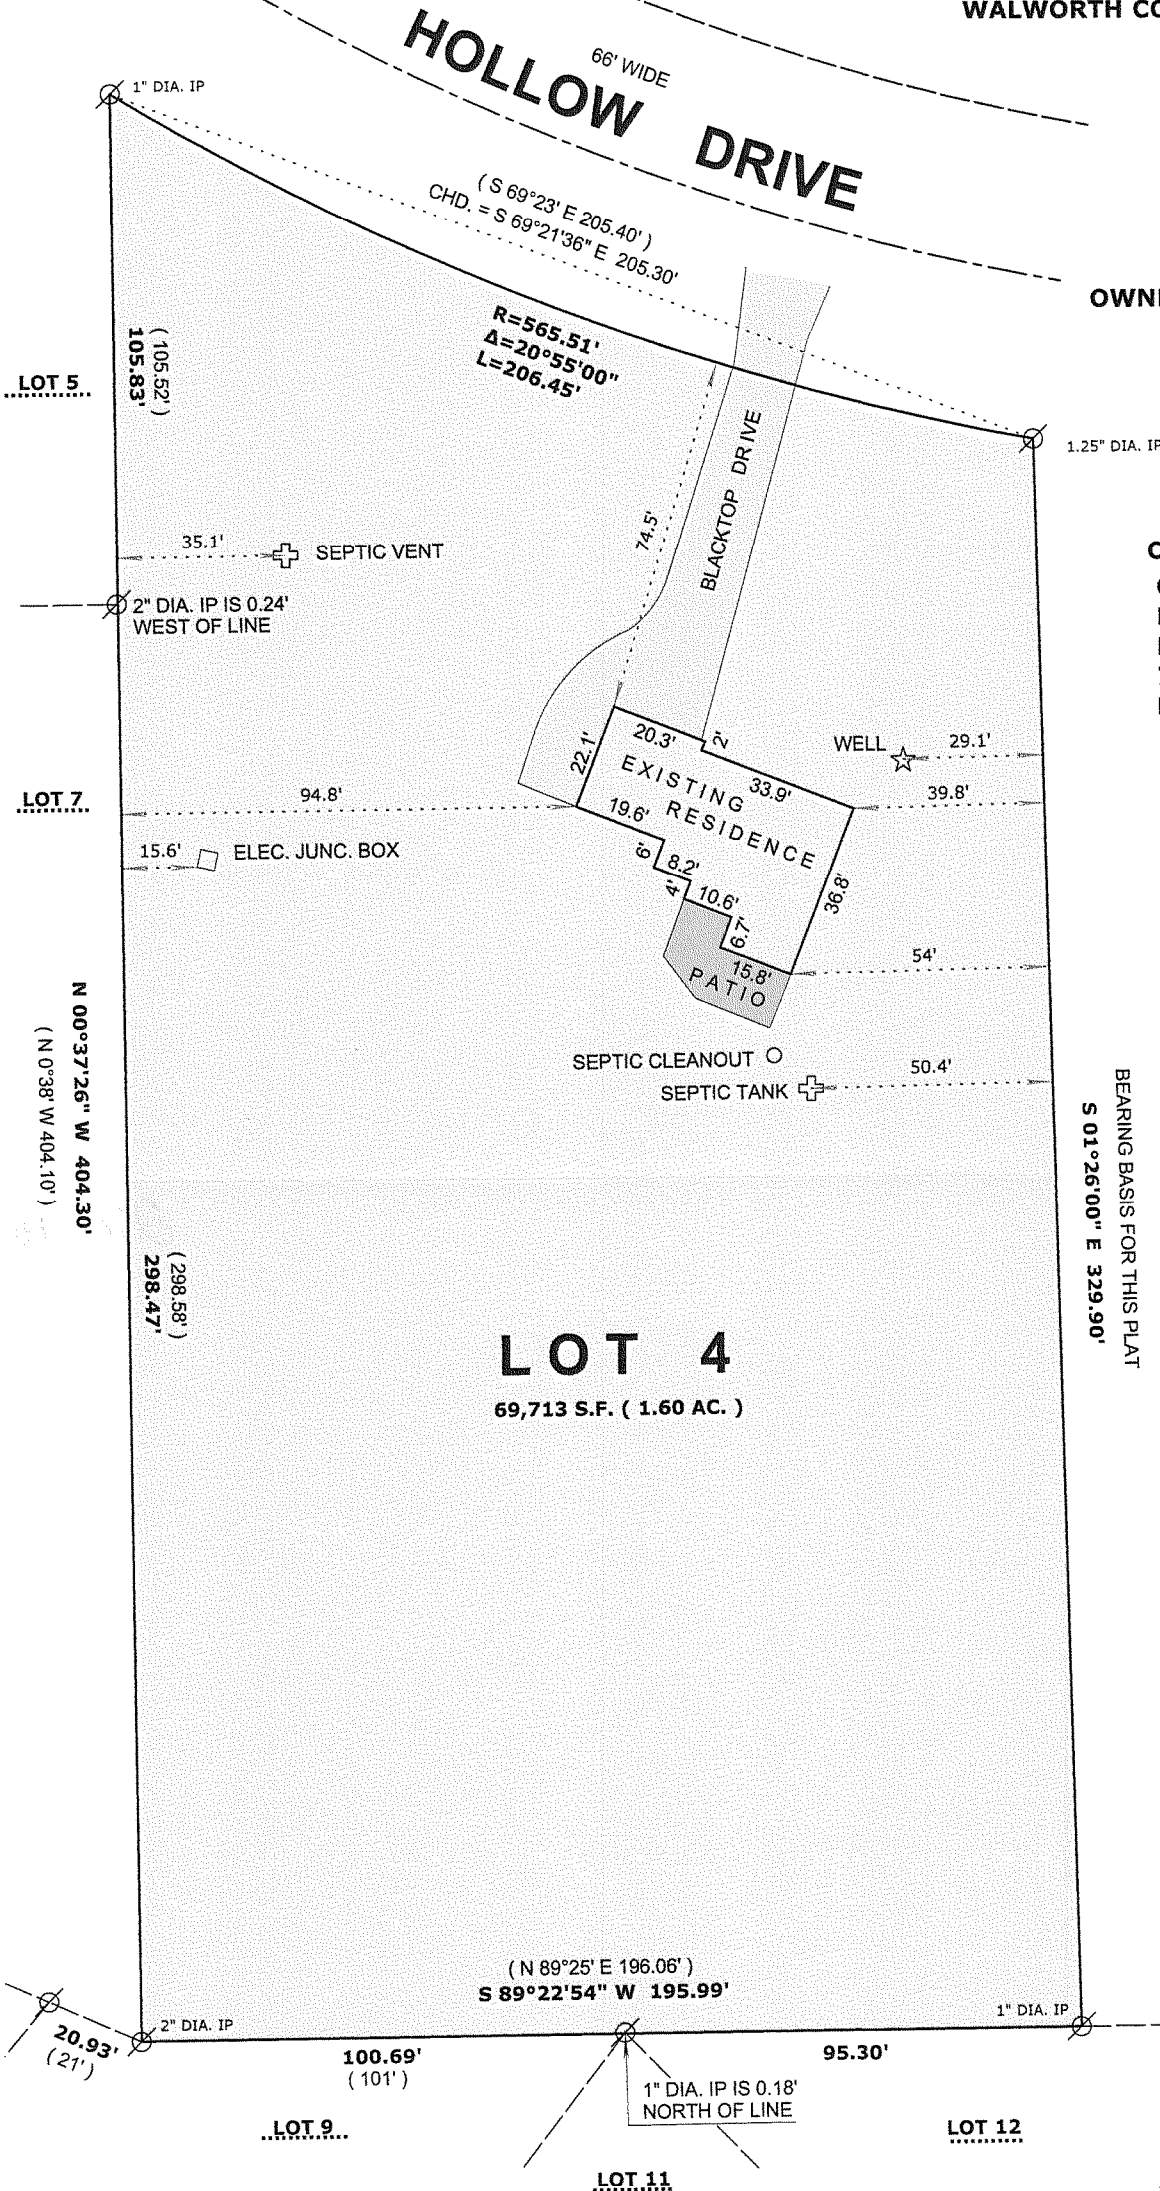

OWNER: NANCY CONSIDINE-CLARK
7345 HOLLOW DR.
LAKE GENEVA, WI. 53147

ORDERED BY: NIKKI WRIGHT
CLOSING ADMINISTRATOR
KEEFE REAL ESTATES, INC.
P.O. BOX 460
751 GENEVA PARKWAY
LAKE GENEVA, WI. 53147

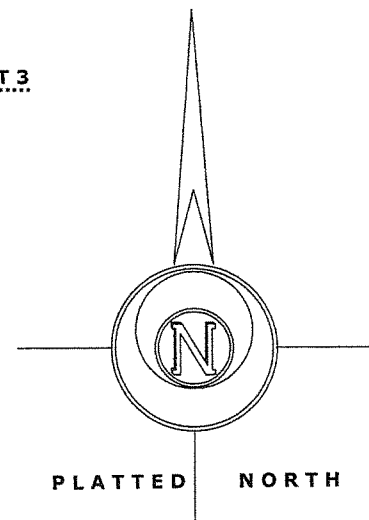

LEGEND


- FOUND IRON PIPE
- FOUND IRON ROD
- FOUND COUNTY MONUMENT
- FOUND CONCRETE MONUMENT
- CHISEL CUT IN CONCRETE
- SET IRON ROD, 24" LONG, WEIGHING 1.5 LBS./LINEAL FT., 3/4" DIA.
- RECORDED AS DIMENSION
- EXISTING FENCE

SCALE: 1" = 40 FEET

"I hereby certify that the above described property has been surveyed by me or under my direction and that the above map is a true representation thereof and shows the size and location of the property, its exterior boundaries, the location of all visible structures and dimensions of all principal buildings thereon, boundary fences, apparent easements, roadways and visible encroachments, if any."
"This survey is made for the use of the present owners of the property, and also those who purchase, mortgage, or guarantee the title thereto within one year from date hereof."

Mark L. Miritz
MARK L. MIRITZ
WISCONSIN REGISTERED
LAND SURVEYOR S-2582

DATE: MAR. 6, 2007 JOB NO. 07.301

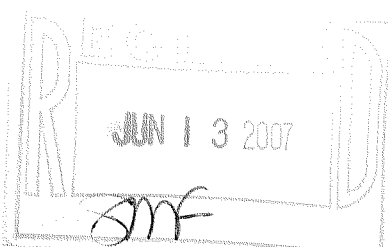

NDE1-4

28-1651