


PLAT OF SURVEY  
UNIT 10 OF BRIDLEWOOD ESTATES  
LOCATED IN PART OF THE NW 1/4 AND THE SW 1/4 OF SECTION 28  
AND PART OF THE NE 1/4 AND SE 1/4 OF SECTION 29, TOWN 2 NORTH,  
RANGE 18 EAST, TOWN OF LYONS, WALWORTH COUNTY, WISCONSIN


LEGAL DESCRIPTION  
Unit 10, together with said unit's undivided appurtenant interest in the common elements and the exclusive use of the limited common elements appurtenant to said unit all in Bridlewood Estates of Lake Geneva Condominium, a condominium declared and existing under and by virtue of the Condominium Ownership Act of the State of Wisconsin and recorded by a Declaration as such condominium in the Office of the Register of Deeds for Walworth County, Wisconsin on June 30, 1995 in Volume 635, Page 6132 through 6183, as Document No. 308533, together with any addendums or amendments thereto, said condominium being located in the Town of Lyons, County of Walworth, State of Wisconsin on the real estate described in said Declaration and incorporated herein by this reference thereto.

Tax Key No. NBRE 00010

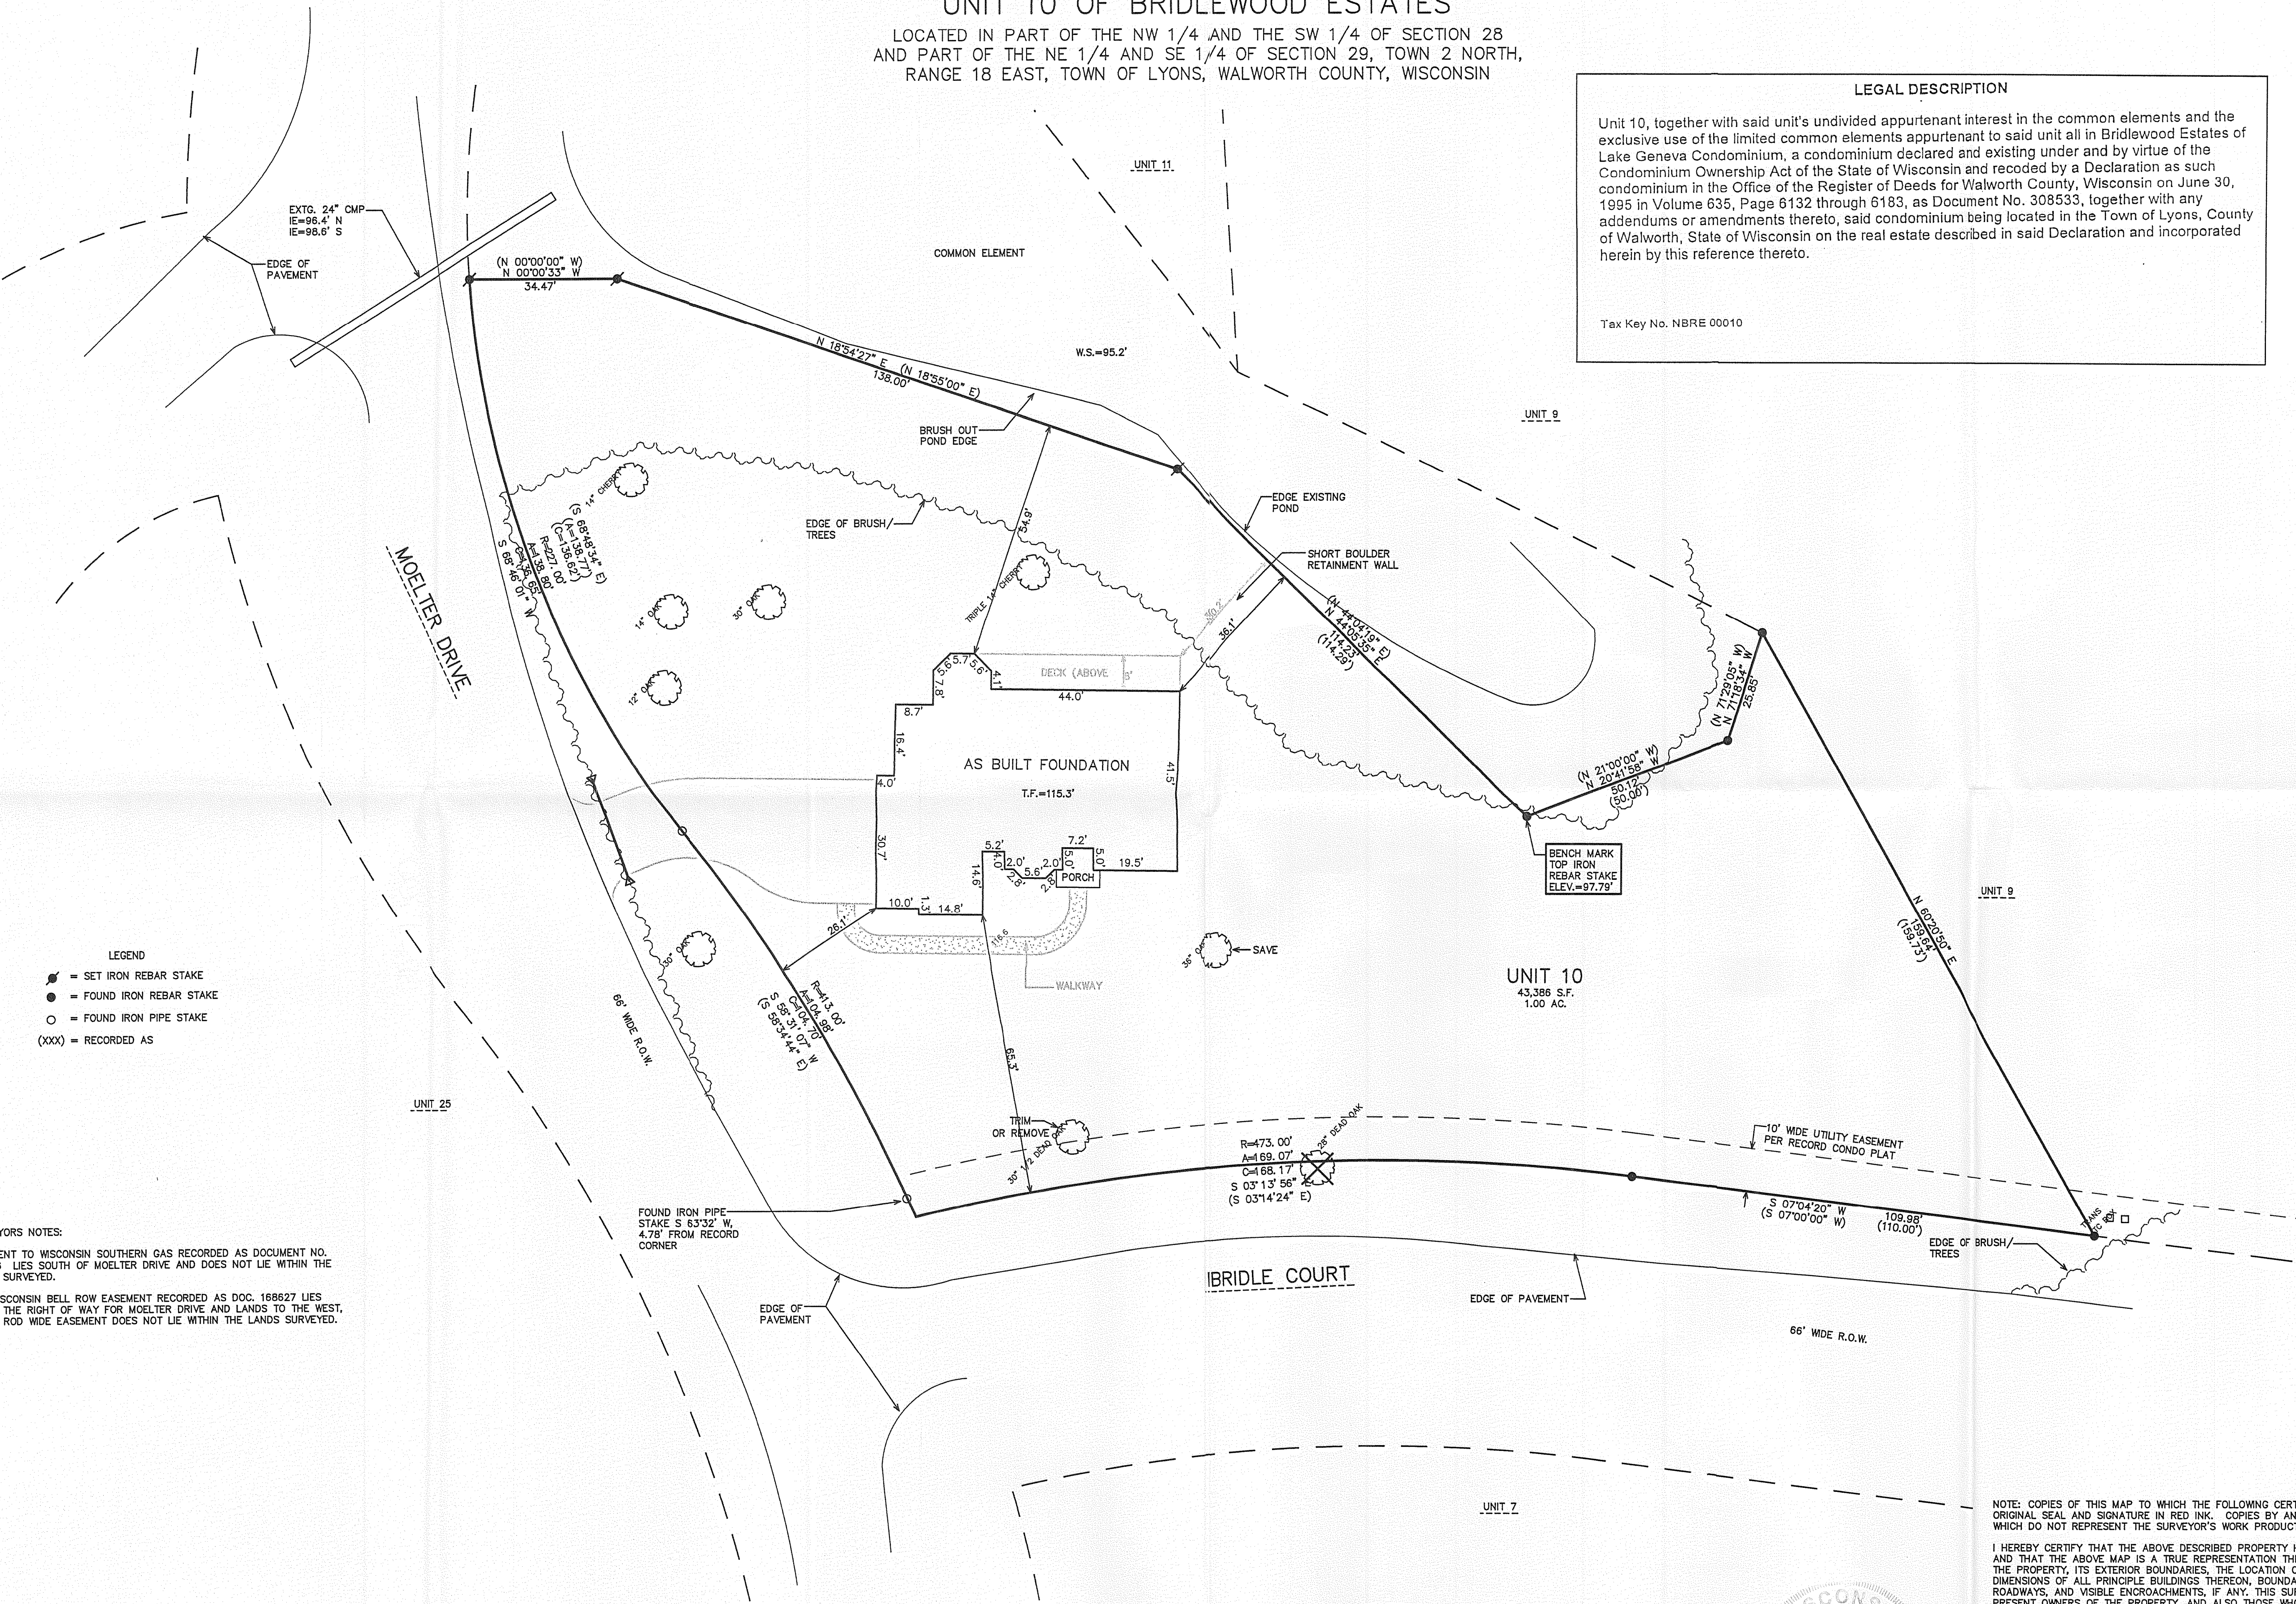

- LEGEND
- = SET IRON REBAR STAKE
  - = FOUND IRON REBAR STAKE
  - = FOUND IRON PIPE STAKE
  - (xxx) = RECORDED AS

SURVEYOR'S NOTES:  
EASEMENT TO WISCONSIN SOUTHERN GAS RECORDED AS DOCUMENT NO. 203196 LIES SOUTH OF MOELTER DRIVE AND DOES NOT LIE WITHIN THE LANDS SURVEYED.  
THE WISCONSIN BELL ROW EASEMENT RECORDED AS DOC. 168627 LIES WITHIN THE RIGHT OF WAY FOR MOELTER DRIVE AND LANDS TO THE WEST, THIS 1 ROD WIDE EASEMENT DOES NOT LIE WITHIN THE LANDS SURVEYED.

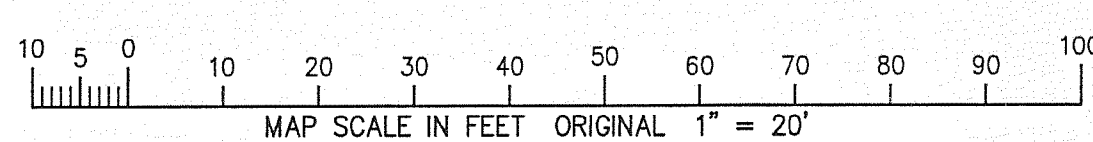

NOTE: COPIES OF THIS MAP TO WHICH THE FOLLOWING CERTIFICATE WILL APPLY SHOW SURVEYOR'S ORIGINAL SEAL AND SIGNATURE IN RED INK. COPIES BY ANY OTHER MEANS MAY HAVE ALTERATIONS WHICH DO NOT REPRESENT THE SURVEYOR'S WORK PRODUCT.

I HEREBY CERTIFY THAT THE ABOVE DESCRIBED PROPERTY HAS BEEN SURVEYED UNDER MY DIRECTION AND THAT THE ABOVE MAP IS A TRUE REPRESENTATION THEREOF AND SHOWS THE SIZE AND LOCATION OF THE PROPERTY, ITS EXTERIOR BOUNDARIES, THE LOCATION OF ALL VISIBLE STRUCTURES, AND DIMENSIONS OF ALL PRINCIPLE BUILDINGS THEREON, BOUNDARY FENCES, APPARENT EASEMENTS, ROADWAYS, AND VISIBLE ENROACHMENTS, IF ANY. THIS SURVEY IS MADE FOR THE USE OF THE PRESENT OWNERS OF THE PROPERTY, AND ALSO THOSE WHO PURCHASE, MORTGAGE, OR GUARANTEE THE TITLE THERETO WITHIN ONE YEAR FROM THE DATE HEREOF.

DATED: JUNE 13, 2008

PETER S. GORDON R.L.S. 2101

REVISED 08-28-2008 TO SHOW SIZE & LOCATION OF AS BUILT FOUNDATION

REVISED 09-11-2008 TO UPDATE MAP TO TITLE SPECIFICATIONS & REFLECT EASEMENT INFORMATION

WORK ORDERED BY -  
ERNIE TUCHESCHER  
GENEVA LAKES DREAM HOMES  
P.O. BOX 259  
FONTANA, WI 53125

FARRIS, HANSEN & ASSOCIATES, INC.  
ENGINEERING - ARCHITECTURE - SURVEYING  
7 RIDGWAY COURT P.O. BOX 437  
ELKHORN, WISCONSIN 53121  
OFFICE: (262) 723-2088 FAX: (262) 723-5886

REVISIONS

06/28/2008	SITE, GRADING, DRAINAGE, AND EROSION CONTROL PLAN
09/08/2008	REVISED SITE, GRADING, DRAINAGE, AND EROSION CONTROL PLAN
7/16/2008-KB	REVISE SITE, GRADING, DRAINAGE, AND EROSION CONTROL PLAN
7/31/2008-KB	REVISE PROPOSED RESIDENCE LOCATION

PROJECT NO.  
7079

DATE  
06/13/06

SHEET NO.  
1 OF 1

NBRE-10

218-1700