
-OF-

LOT 1 CERTIFIED SURVEY MAP NO. 89, LOCATED IN THE NORTHWEST 1/4 OF THE SOUTHEAST 1/4 OF SECTION 22, TOWN 2 NORTH, RANGE 18 EAST, WALWORTH COUNTY, WISCONSIN.



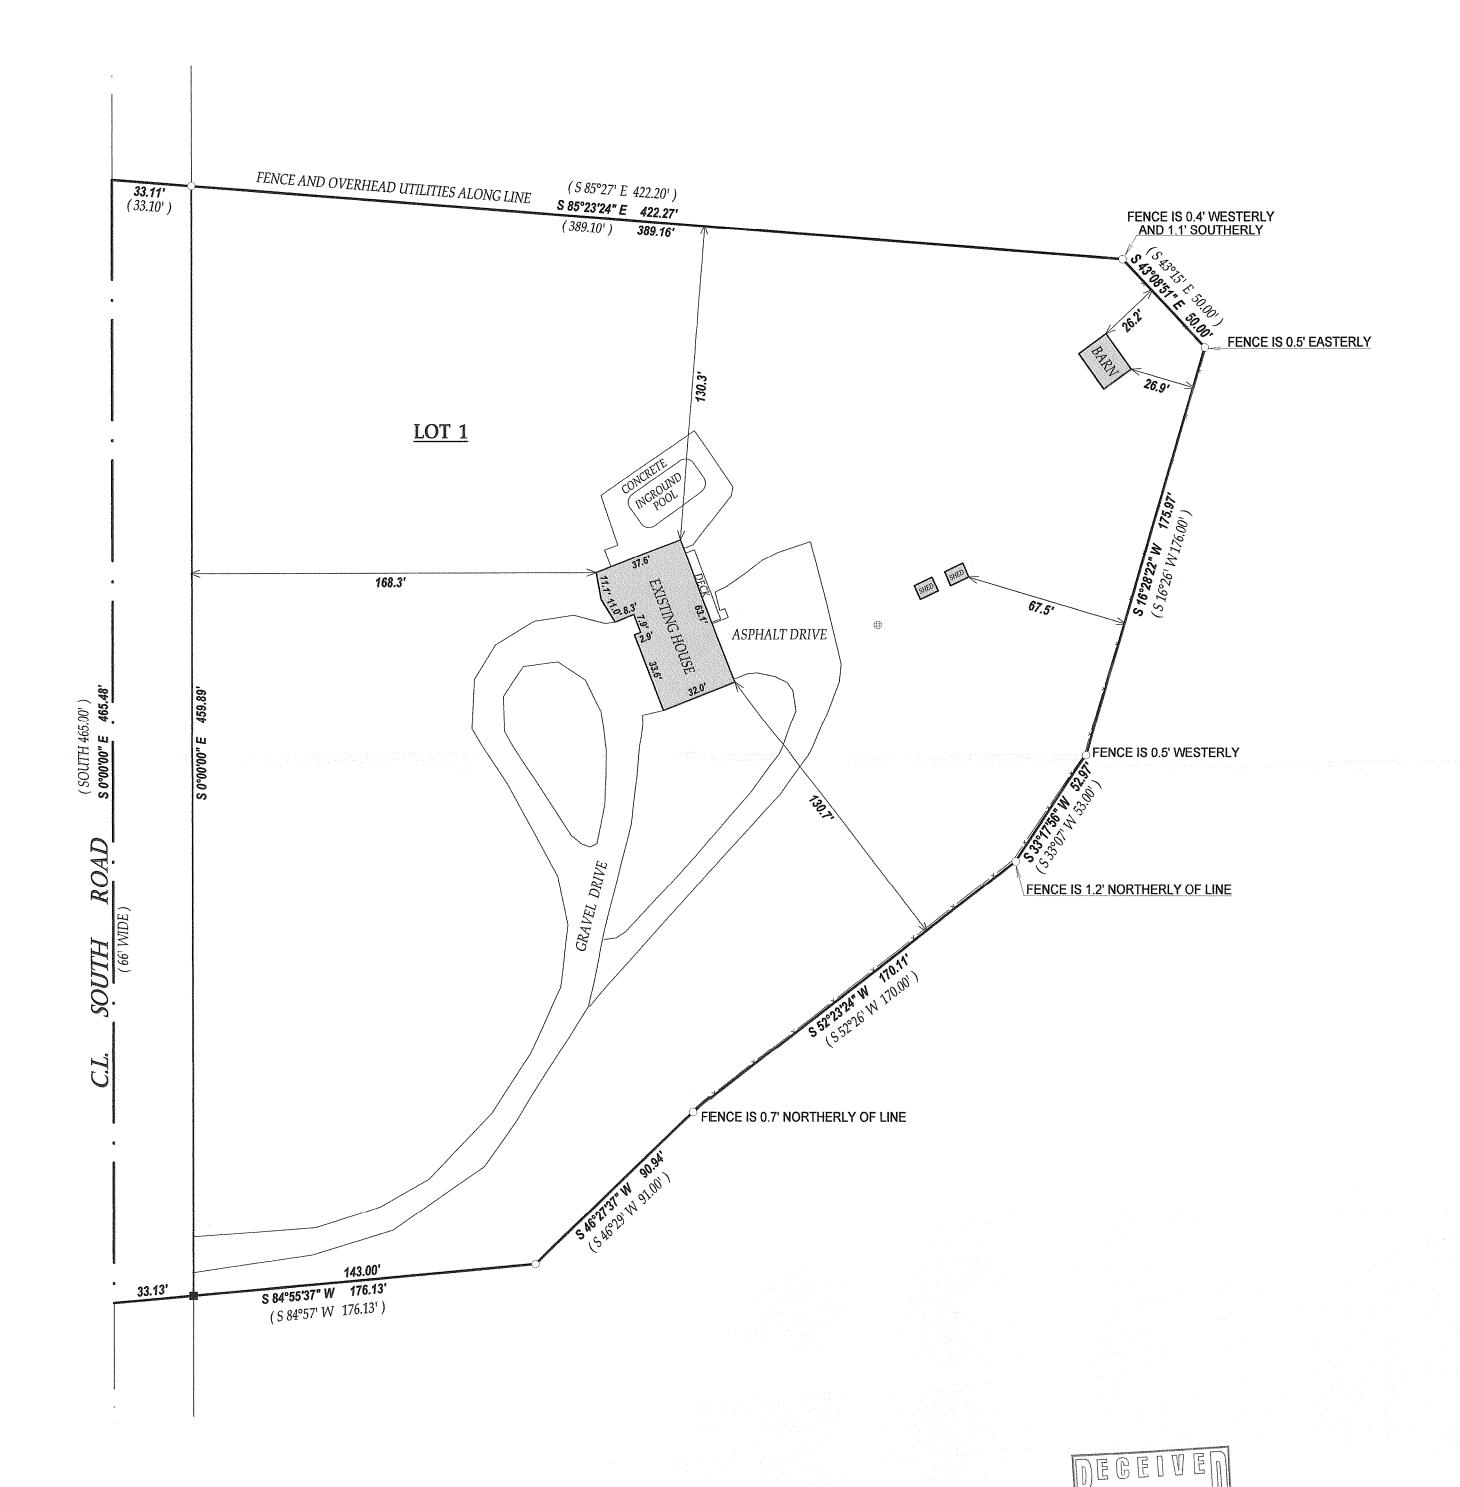


• FOUND IRON PIPE

SET IRON BAR

CONCRETE LID

(XX) RECORDED AS
TAX 1D # NA8900001

JOB # 09-088

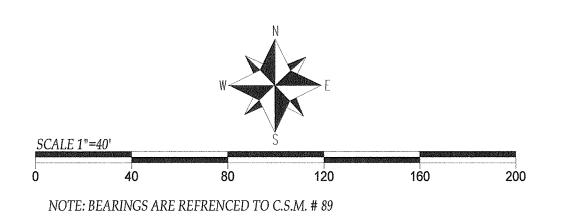

"I hereby certify that I have surveyed the above described property and that the above map is a true representation thereof and shows the size and location of all visible structures, apparent easements and encroachments if any."

This survey is made for the present owners of the property, and those who purchase, mortgage, or guarentee the title thereto, within one year from the date hereof.

JOHN KROTT S - 2258
Wisconsin Registered Land Surveyor
(original if signed in red)
DATED THIS 14th DAY OF JULY 2009.

