PLAT OF SURVEY

-0F-

LOTS 1-4, BLOCK 21 AND ADJACENT LAND TO RAILROAD RIGHT - OF - WAY, SPRINGFIELD SUBDIVISION, SECTION 7, TOWNSHIP 2 NORTH, RANGE 18 EAST, WALWORTH COUNTY, WISCONSIN.

SURVEY FOR: KAREN SCHINKE

SURVEY LOCATION: 1722 HIGHWAY "120"

SCALE: 1" = 40'

LEGEND

- O FOUND IRON PIPE
- O FOUND 2" DIA. IRON PIPE


"I hereby certify that I have surveyed the above described property and that the above map is a correct representation thereof and shows the size and location of the property, its exterior boundaries, the location of all visible structures and dimensions of all principal buildings thereon, boundary fences, apparent easements, roadways and encroachments, if any."

"This survey is made for the use of the present owners of the property, and those who purchase, mortgage, or guarantee the title thereto within one year from date hereof."



B.W. SURVEYING, INC.

LAND SURVEYS
MAPPING AND PLANNING
412 N. PINE STREET
BURLINGTON, WI 53105
(262)-767-0225

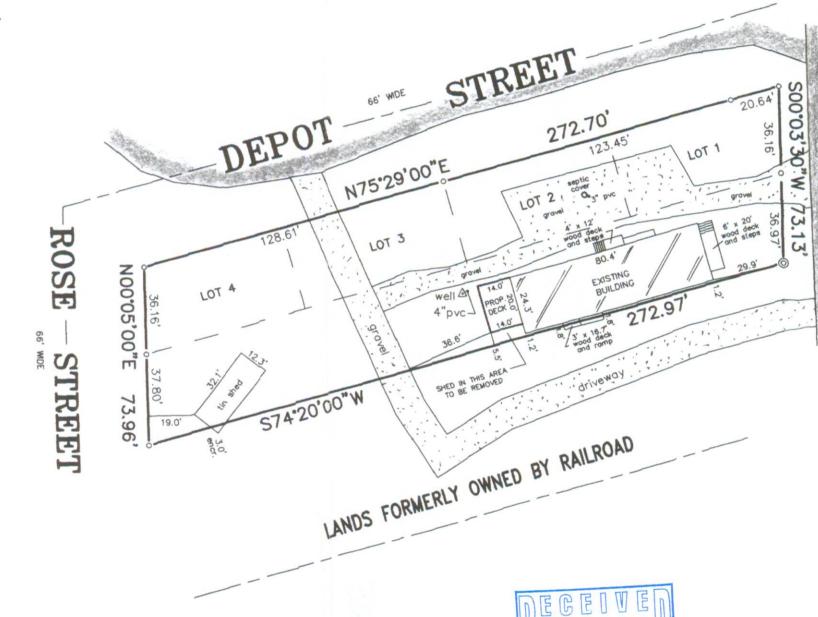

THIS IS NOT AN ORIGINAL PRINT UNLESS THIS SEAL IS RED.

VISCON,

ROBERT. WETZEL

S-1778 BURLINGTON

(a.k.a.

Main

Street)

H

ROBERT J. WETZELD S-1778

REVISED: JULY 14, 2009 JULY 15, 2003

DATE

JOB NUMBER

218-173-

NVS-52