

PREPARED FOR
ROBERT PHILLIPS
1498 PLEASANT ST.
BURLINGTON WI. 53105



PLAT OF SURVEY

-OF-


UNIT 114 OF COUNTRY ESTATES CONDOMINIUM
LOCATED IN THE NORTHEAST 1/4 OF SECTION 7
AND THE NORTHWEST 1/4 OF SECTION 8, TOWN
2 NORTH, RANGE 18 EAST, WALWORTH COUNTY,
WISCONSIN.

KROTT SURVEYING INC.

N3705 WILLOW BEND LANE
LAKE GENEVA WI. 53147
PHONE # (262)248-3697
FAX # (262)249-0639

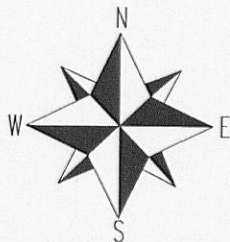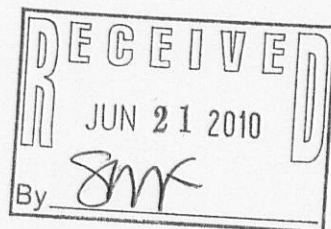


SCALE 1" = 20'

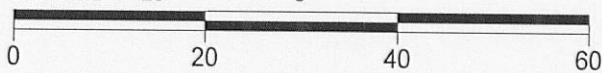

NOTE: BEARINGS ARE REFERENCED TO THE RECORD PLAT OF COUNTRY ESTATES CONDO. AND THE WEST LINE OF PLEASANT STREET WAS ASSUMED TO BEAR S 0°30'45" E.

I have surveyed the above-described property and the above map is a true representation thereof and shows the size and location of the property, its exterior boundaries, the location and dimensions of all structures thereon, fences apparent easements and roadways and visible encroachments, if any.

This survey is made for the exclusive use of the present owners of the property, and also those who purchase, mortgage, or insure the title thereto within one (1) year from date hereof; and as to them I warrant the accuracy of said survey map.

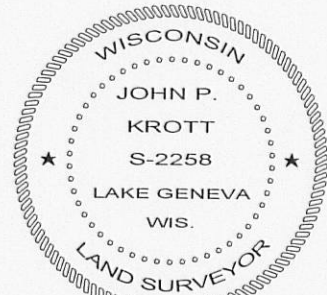

DATED THIS 13th DAY OF APRIL 2010.

John P. Krott

JOHN KROTT S - 2258
Wisconsin Registered Land Surveyor
(original if signed in red)

LEGEND

- FOUND IRON PIPE
- FOUND IRON BAR
- SET IRON BAR
- ⊙ UTILITY PEDESTALS
- ⊕ MANHOLE

(xx) RECORDED AS

TAX ID # NCS00114
JOB # 10-065