

PLAT OF SURVEY

LOT 13
OF MEADOW HILL FARMS

A SUBDIVISION LOCATED IN THE SOUTH 1/2 OF THE
SE 1/4 OF SECTION 32, TOWN 1 NORTH, RANGE 18 EAST,
WALWORTH COUNTY, WISCONSIN

COBBLE CREEK DRIVE
66' WIDE R.O.W.

(640.00')
640.04'
N 86°58'55" W

LOT 13
218,801 S.F.
5.02 AC.

LOT 11

EDGE OF PAVEMENT

(S 41°13'05" E)
(S 35°41'00" E)
(596.25')

LOT 12

○ = FOUND IRON PIPE STAKE
● = FOUND IRON REBAR STAKE
(XXX) = RECORDED AS

ASSIGNED NORTH LINE
LOT 13 OF
MEADOW HILL FARMS
N 86°58'55" W

20.2'
SHED

59.7'

24.3'
GARAGE

25.0'
PAVEMENT

12.7'

19.4'

10.9'

14.6'

10.7'

14.6'

10.7'

14.6'

STORAGE
SHED

WOOD FENCE
0.5' WEST OF LINE

113.6'

(N 00°20'46" E)
(475.50')
(W 08°25'53" W)
(475.44')

TRANS. BL.

349.9'

14.6'

10.7'

14.6'

10.7'

14.6'

NOTE: COPIES OF THIS MAP TO WHICH THE FOLLOWING CERTIFICATE
WILL APPLY SHOW SURVEYOR'S ORIGINAL SEAL AND SIGNATURE IN
RED INK. COPIES BY ANY OTHER MEANS MAY HAVE ALTERATIONS
WHICH DO NOT REPRESENT THE SURVEYOR'S WORK PRODUCT.



I HEREBY CERTIFY THAT THE ABOVE DESCRIBED PROPERTY HAS BEEN
SURVEYED UNDER MY DIRECTION AND THAT THE ABOVE MAP IS A TRUE
REPRESENTATION THEREOF AND SHOWS THE SIZE AND LOCATION OF
THE PROPERTY AND ITS EXTERIOR BOUNDARIES. THIS SURVEY IS
MADE FOR THE USE OF THE PRESENT OWNERS OF THE PROPERTY, AND
ALSO THOSE WHO PURCHASE, MORTGAGE, OR GUARANTEE THE TITLE
THERETO WITHIN ONE YEAR FROM THE DATE HEREOF.



DATED: 01/16/02

REVISED & RECERTIFIED 07-03-2013

Peter S. Gordon
PETER S. GORDON R.L.S. 2101

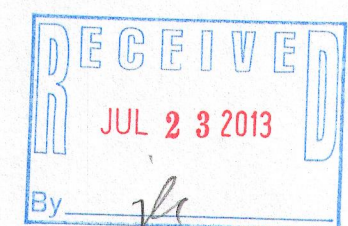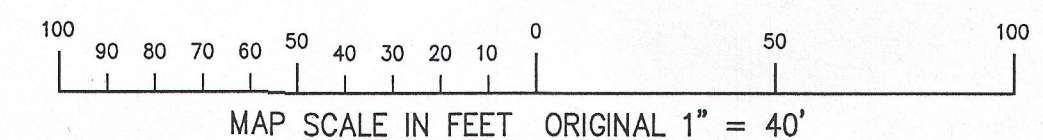

WORK ORDERED BY -
JUDY CALL
6723 COBBLE CREEK DRIVE
LAKE GENEVA, WI 53147

FARRIS, HANSEN & ASSOCIATES, INC.
ENGINEERING - ARCHITECTURE - SURVEYING
7 RIDGWAY COURT P.O. BOX 437
ELKHORN, WISCONSIN 53121
OFFICE: (262) 723-2098 FAX: (262) 723-5886

REVISIONS

PROJECT NO.
5960
DATE:
01/16/02
SHEET NO.
1 OF 1

NMH -13

218-1835