

PREPARED FOR:
RONALD E. DORN
323 E. NORTH ST.
JEFFERSON, WI 53549

PLAT OF SURVEY

-OF-


LYNCH & ASSOCIATES
ENGINEERING CONSULTANTS, LLC.

405 SKYLINE DRIVE, SUITE C
LAKE GENEVA, WI 53147
(262) 248-3697

UNIT 162 COUNTRY ESTATES CONDOMINIUM, ACCORDING TO
THE RECORDED PLAT THEREOF, LOCATED IN THE NORTHWEST
1/4 OF SECTION 8, TOWN 2 NORTH, RANGE 18 EAST, TOWN
OF LYONS, WALWORTH COUNTY, WISCONSIN.

NOTE:
THE PROPOSED MOBILE HOME IS TO BE PLACED IN THE
SAME LOCATION AS THE EXISTING MOBILE HOME.

C/L SUNRISE TRAIL
(36' WIDE PRIVATE ROAD)

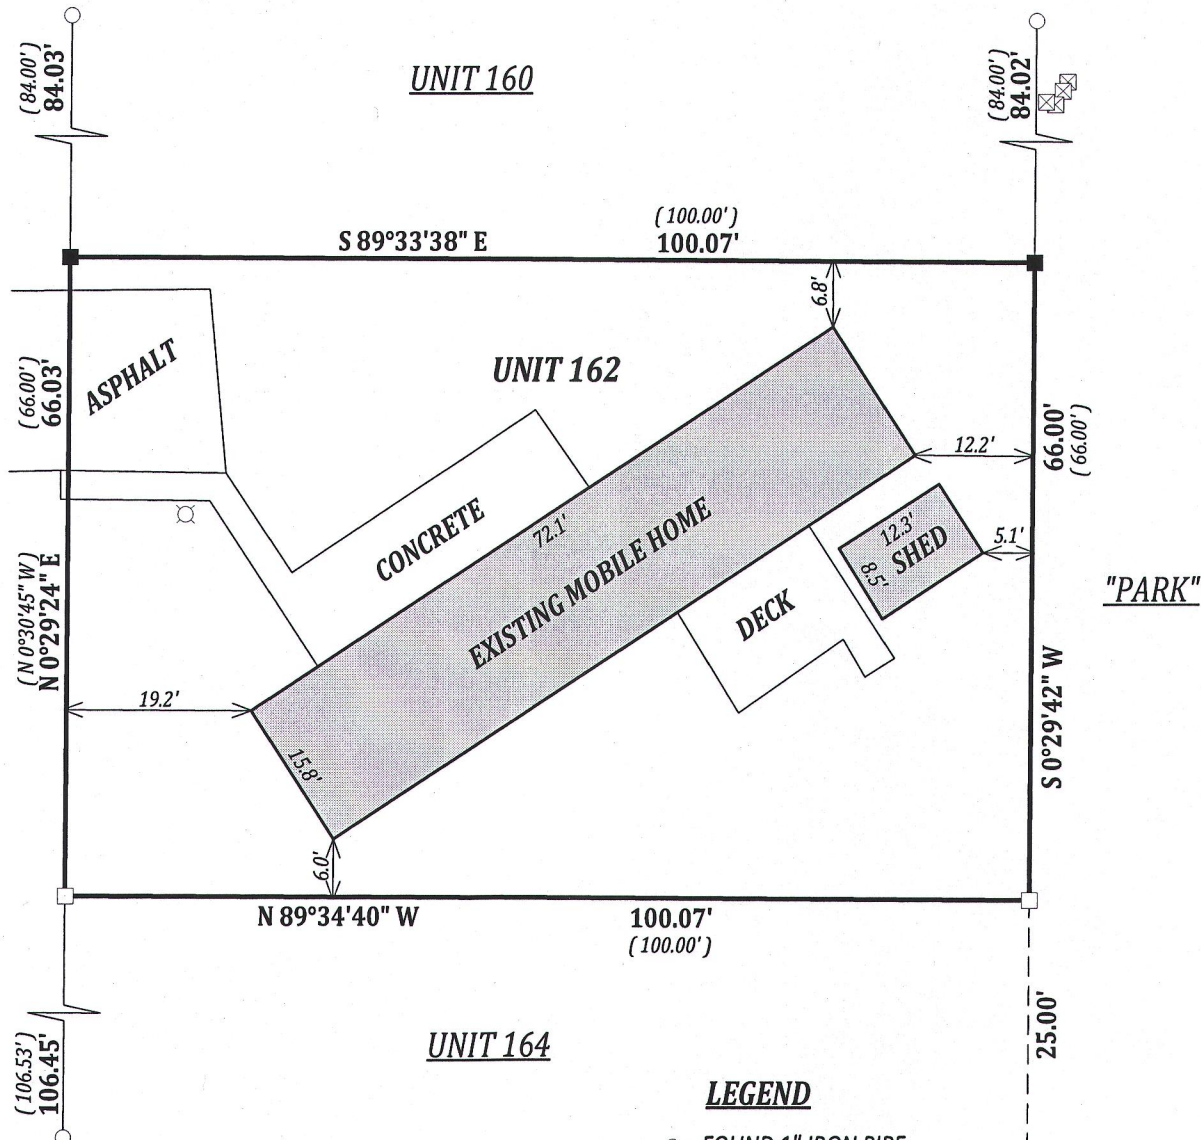

NOTE:

No title commitment or results of a title search were provided to this office pertaining to this survey. This Plat Of Survey may not reflect easements of record, encumbrances, restrictions, ownership, title evidence, or other facts that a current and accurate title search may disclose.

I have surveyed the above-described property and the above map is a true representation thereof and shows the size and location of the property, its exterior boundaries, the location and dimensions of all structures thereon, fences apparent easements and roadways and visible encroachments. if any.

This survey is made for the exclusive use of the present owners of the property, and also those who purchase, mortgage, or insure the title thereto within one (1) year from date hereof; and as to them I warrant the accuracy of said survey map.

JOB # 15-558
TAX ID # NCS 00162

NCS-162 218-1899