


- FOUND IRON PIPE
- SET IRON PIPE
- () RECORDED AS

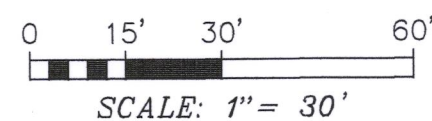

SATTER SURVEYING, LLC
LAND SURVEYS, MAPPING AND PLANNING
272 ORIGIN STREET
BURLINGTON, WI 53105
262-661-4239

BLOCK 26 OF THE ORIGINAL PLAT OF SPRINGFIELD

(312.71')
312.58'

N00°01'58"E

STATE ——— TRUNK ——— ^(56" WIDE) HIGHWAY ——— "120"

(66.00')
66.18'

LOT 2

LOT 1

Found an iron pipe 1.05' west of set iron pipe.

Shed corner is
0.7' south of the
property line.

Shed corner is
0.7' north of the
property line.

EAST

EXISTING SHED

LOT 3

Note: The dry wells and grease trap as shown are believed to be as labeled hereon. However, this office could not positively identify with absolute certainty.

dry well

LOT 4

0.80 total acres

BLOCK 27

LOT 6

EXISTING
SHED

LOT 5


2" dia. post is
1.6' north of the
property line. 

Diagram showing a shed and a lean-to structure. The shed is 5.2' x 9.2'. The lean-to is 263.91' (264.00') long. The bearing is Northwe.

Northwest corner of lean-to is 0.9' south of the property line.
Northeast corner of lean-to is 0.4' south of the property line.

LOT 8

LOT 7

— Property line as surveyed
by Lloyd Jensen dated
September, 1959.

DEPOT STREET

PLAT OF SURVEY
-OF-

SURVEY FOR: JOHN LAW OF RE/MAX PLAZA
SURVEY ADDRESS: 1699 HIGHWAY 120

RECEIVED
JUN 16 2017
By *SMK*



THIS IS NOT AN ORIGINAL PRINT
UNLESS THIS SEAL IS RED.

THOMAS L. SATTER S-285

MAY 24, 2017
DATE

051711
JOB NUMBER

218-1971