AND-MARK SURVEYING Mark L. Miritz

Wisconsin Professional Land Surveyor S-2582

N9330 Knuteson Drive Whitewater, WI 53190 Phone:(262)495-3284 MARKMIRITZ@ LAND-MARKSURVEYING.COM

PLAT OF SURVEY

LOT 1 OF CERTIFIED SURVEY MAP NO. 776 RECORDED APRIL 25, 1978 IN VOLUME 3 OF CERTIFIED SURVEYS AT PAGE 306 AS DOCUMENT NO. 31670, BEING A PART OF THE NORTHEAST 1/4 OF THE NORTHEAST 1/4 OF SECTION 22, TOWN 2 NORTH, RANGE 18 EAST, LYONS TOWNSHIP, WALWORTH COUNTY, WISCONSIN.


MARK L. MIRITZ

DATE: DEC. 16, 2017

WISCONSIN PROFESSIONAL **LAND SURVEYOR S-2582**

JOB NO. 17.1210

ORDERED BY: **MICHAEL & PEGGY BENTLEY KEEFE REAL ESTATE 751 GENEVA PARKWAY**

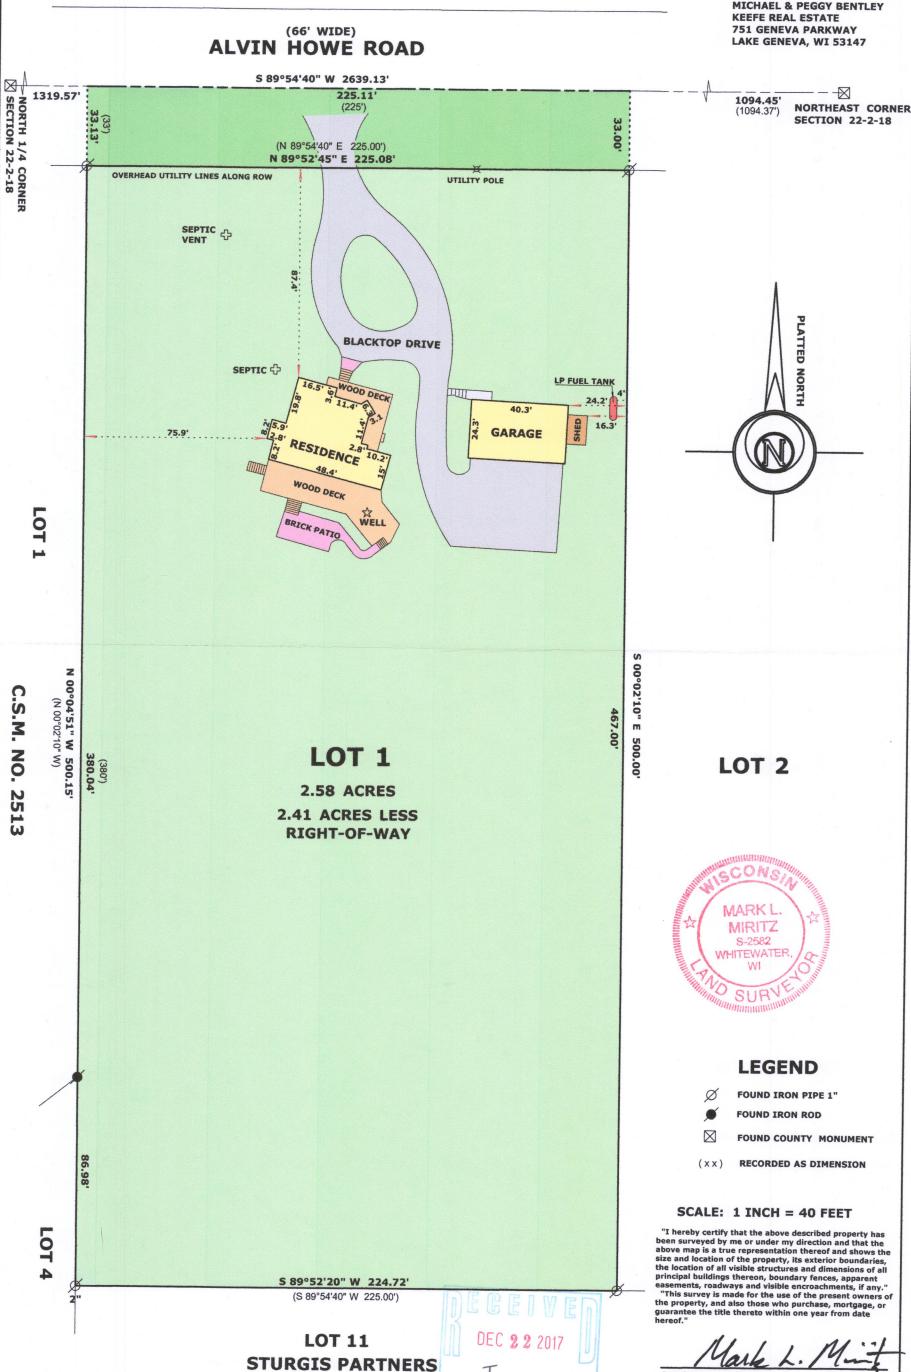

NA 776-1 218-1989