
PLAT OF SURVEY -OF-

LOTS 9, 10, 11, 12,13 AND 14, IN BLOCK 8 OF THE VILLAGE OF SPRINGFIELD, A SUBDIVISION LOCATED IN SECTION 7, TOWNSHIP 2 NORTH, RANGE 18 EAST OF THE FOURTH PRINCIPAL MERIDIAN, TOWNSHIP OF LYONS, COUNTY OF WALWORTH, STATE OF WISCONSIN.

ALSO: THE WEST 1/2 OF VACATED WEST STREET AS VACATED UNDER DOC. NO. 847388 VILLAGE OF SPRINGFIELD.

SURVEY FOR: BILL CORCORAN

SURVEY ADDRESS: 7282 SPRINGFIELD RD.

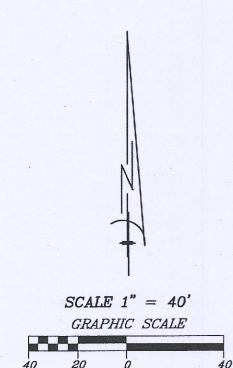

"I hereby certify that I have surveyed the above described property and that the above map is a correct representation thereof and shows the size and location of the property, its exterior boundaries, the location of all visible structures and dimensions of all principal buildings thereon, boundary fences, apparent


FOR PRIVATE USE'
STREET

"RESERVED

PLATTED AS WEST

"This survey is made for the use of the present owners of the property, and those who purchase, mortgage, or guarantee the title thereto within one year from date hereof."

easements, roadways and encroachments, if any.

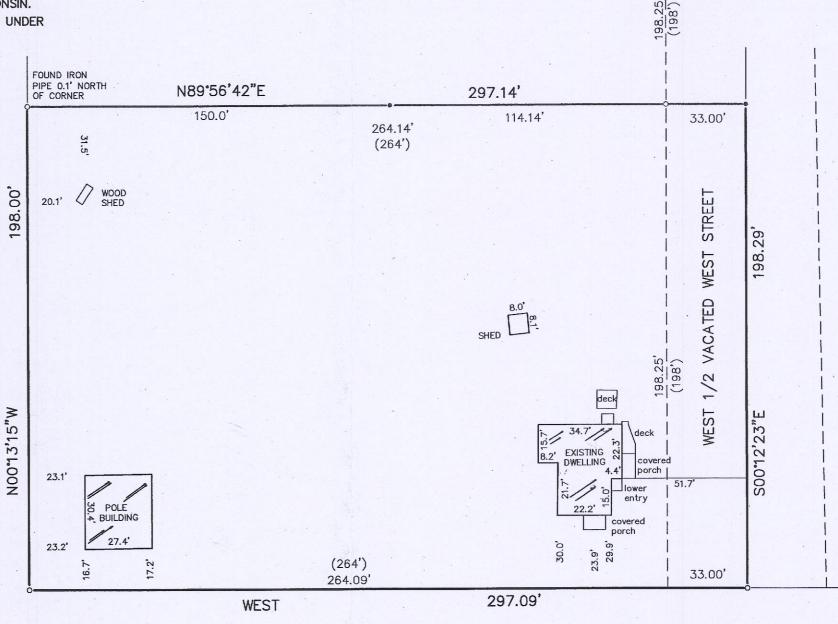


SPRINGFIELD ROAD



B.W. SURVEYING, INC.

LAND SURVEYS MAPPING AND PLANNING 412 N. PINE STREET BURLINGTON, WI 53105 (262) - 767 - 0225

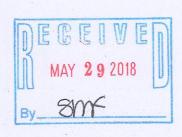

THIS IS NOT AN ORIGINAL PRINT UNLESS THIS SEAL IS RED.

LEGEND

O FOUND IRON PIPE

SET IRON PIPE

SCOM

ROBERTJ

WETZEL

S-1778

BURLINGTON

ROBERT J. WETZEL

DECEMBER 26, 2017 DATE

9520 JOB NUMBER