



WORK ORDERED BY:
JORNDT-FAHEY, LLC
168 ELKHORN ROAD

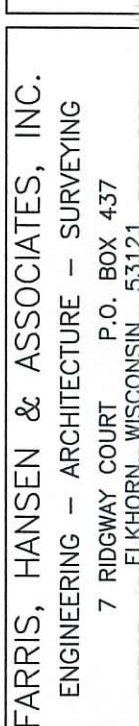

REVISION
6/11/21 NEW GARAGE
7/16/2024 AS-BUILT GARAGE
PROJECT NO. 9646..
DATE: 11-11-21
SHEET NO. 1 OF 1

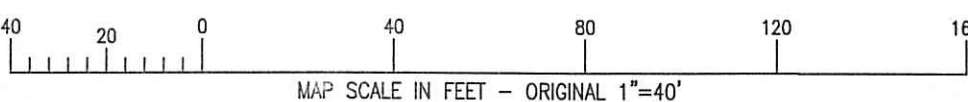

LEGEND
○ = FOUND IRON PIPE STAKE
(XXX) = RECORDED AS

I HEREBY CERTIFY THAT THE ABOVE DESCRIBED PROPERTY HAS BEEN SURVEYED UNDER MY DIRECTION AND THAT THE ABOVE MAP IS A TRUE REPRESENTATION THEREOF AND SHOWS THE SIZE AND LOCATION OF THE PROPERTY AND ITS EXTERIOR BOUNDARIES. THIS SURVEY IS MADE FOR THE USE OF THE PRESENT OWNERS OF THE PROPERTY, AND ALSO THOSE WHO PURCHASE, MORTGAGE, OR GUARANTEE THE TITLE THERETO WITHIN ONE YEAR FROM THE DATE HEREOF.

CHRISTOPHER A. HODGES P.L.S. S-2760

