


-OF-

WALWORTH COUNTY, WISCONSIN.

LAKE GENEVA, WI 531

ON EASEMENTS, RESTRICTIONS OR COVENANTS WHICH MAY AFFECT THIS PROPERTY.

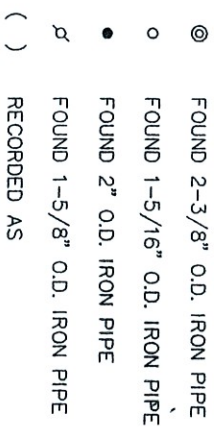


FIRST ADDITION: ASSUMED BEARING OF SOUTH 08°42'10" EAST AS PLATTED.

BOUNDARY FENCES, APPACH  
ENCROACHMENTS, IF ANY."

MORTGAGE, OR GUARANTEE  
YEAR FROM DATE HEREOF

DOCKING, W. 2010  
262-661-4239

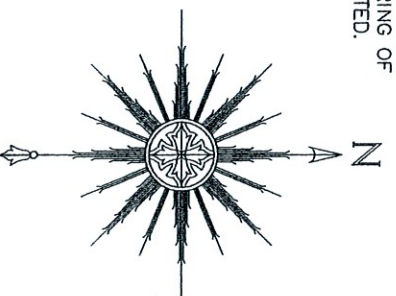

UNLESS THIS SEAL IS RED.

THOMAS L. SATTER

S-2850

DATE \_\_\_\_\_

JOB NUMBER