


929 WILLIAMS STREET LAKE GENEVA, WISCONSIN 53147 414-248-3697



LEGEND

- BARRY DRIVE

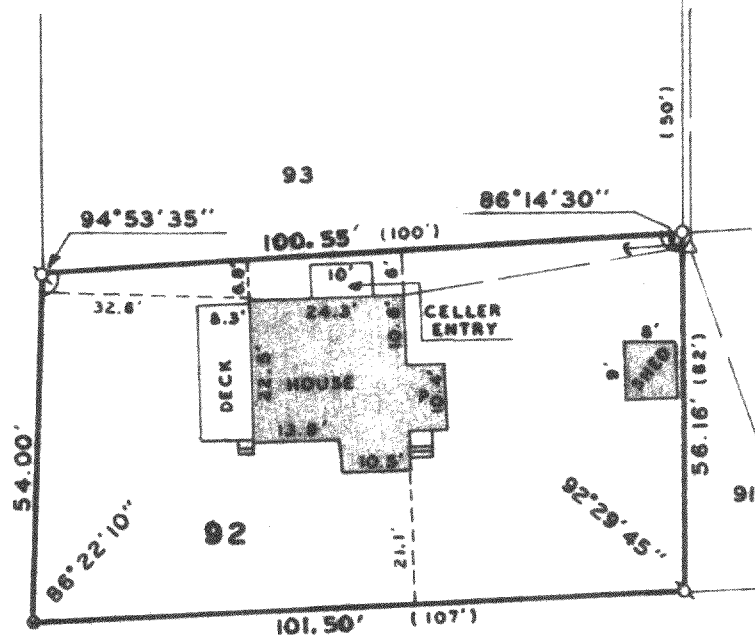

PLAT OF SURVEY OF

RECEIVED
NOV 13 1986

THIS SIURVEY IS MADE FOR THE USE OF THE
PRESENT OWNERS OF THE PROPERTY AND ALSO
THOSE WHO PURCHASE, MORTGAGE, OR GUARANTEE
THE TITLE THERETO WITHIN ONE (1) YEAR FROM
DATE HEREOF.

REVISÉD.

