

WALWORTH COUNTY SURVEYING & MAPPING LAKE GENEVA, WISCONSIN

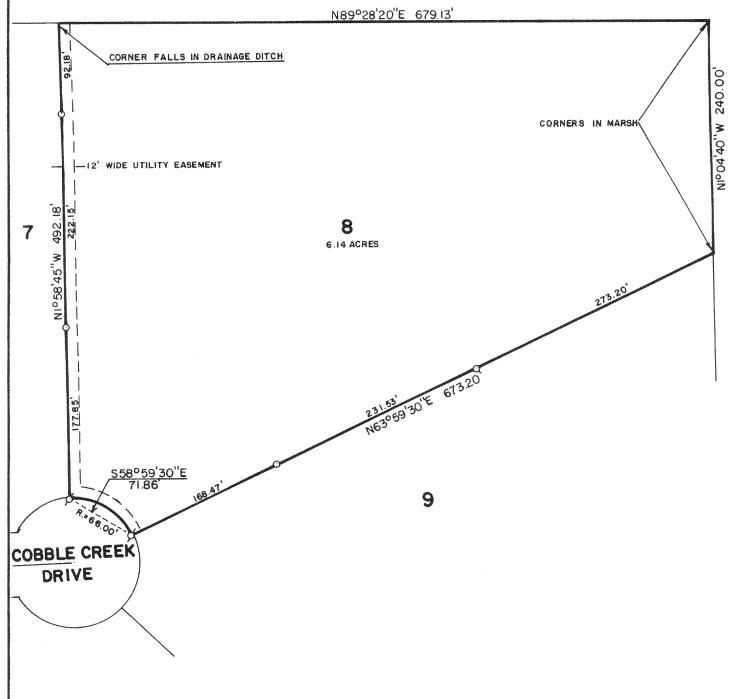

PLAT OF SURVEY OF

LOT 8 OF MEADOW HILL FARMS, LOCATED IN SECTION 32, T 2 N, R 18 E, WALWORTH COUNTY, WISCONSIN.

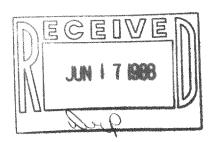

ORDERED BY: KEEFE REAL ESTATE

704 MAIN STREET

LAKE GENEVA, WISCONSIN

53147



SCALE: 1"=100'

ø -IRON PIPE FOUND ○ -IRON ROD PLACED I, ROBERT M. BAERENWALD, DO HEREBY CERTIFY THAT I HAVE SURVEYED THE PROPERTY HEREON DESCRIBED ACCORDING TO THE OFFICIAL RECORDS AND THAT THE PLAT HEREON IS A CORRECT REPRESENTATION OF THE PROPERTY LINES TO THE BEST OF MY KNOWLEDGE AND BELIEF.

ROBERT M. BAERENWALD

WISCONSIN REGISTERED LAND SURVEYOR, 5-1508

DATE JOB NO. 1234

NOTE: THIS IS NOT A CERTIFIED COPY UNLESS SEALED.

8-HMN