

## WALWORTH COUNTY SURVEYING & MAPPING 727 HENRY STREET LAKE GENEVA, WISCONSIN 414-248-0505

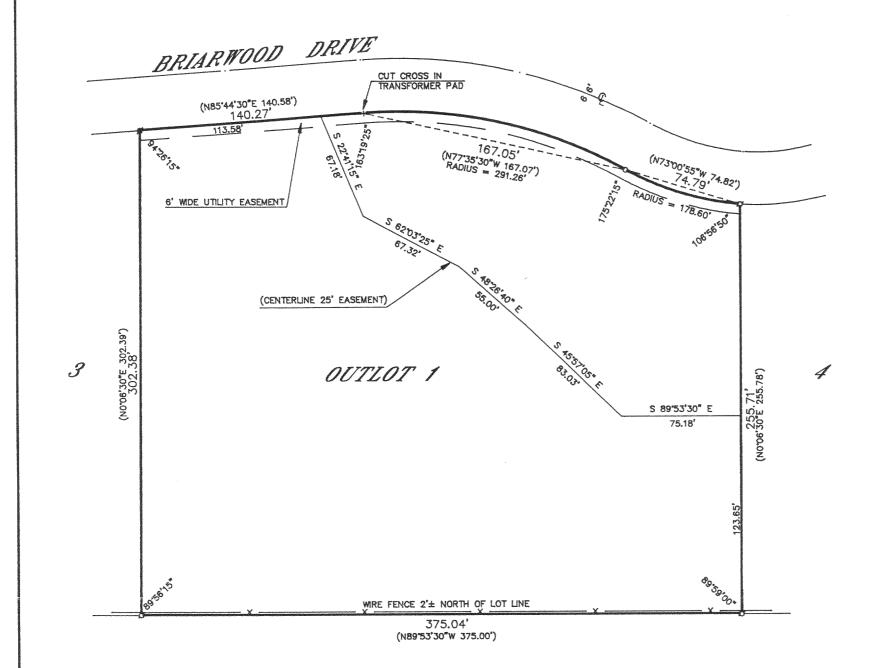

## PLAT OF SURVEY OF

OUTLOT 1 OF BRIARWOOD SUBDIVISION, LOCATED IN SECTION 21, T 2 N, R 18 E, WALWORTH COUNTY, WISCONSIN.

ORDERED BY: VACATION PROPERTIES NETWORK
101 BROAD STREET
LAKE GENEVA, WISCONSIN
53147

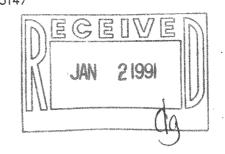

I HEREBY CERTIFY THAT I HAVE SURVEYED THE ABOVE DESCRIBED PROPERTY AND THAT I HE ABOVE MAP IS A TRUE REPRESENTATION THEREOF AND SHOWS THE SIZE AND LOCATION OF THE PROPERTY, ITS EXTERIOR BOUNDARIES, THE LOCATION OF ALL VISIBLE STRUCTURES AND DIMENSIONS OF ALL PRINCIPAL BUILDINGS THEREON, BOUNDARY FENCES, APPARENT EASEMENTS, ROADWAYS AND VISIBLE ENCROACH—240 MENTS, IF ANY, TO THE BEST OF MY KNOWLEDGE AND BELIEF.

THIS SURVEY IS MADE FOR THE USE OF THE PRESENT OWNERS OF THE PROPERTY AND ALSO THOSE WHO PURCHASE, MORTGAGE OR GUARANTEE THE TITLE THERETO WITHIN ONE (1) YEAR FROM DATE HEREFOR

ROBERT M. BAERENWALD
MISCONSIN REGISTERED LAND SURVEYOR, S-1508

March 2/1990

DATE JOB NO. 2419

NOTE: THIS IS NOT A CERTIFIED COPY UNLESS SEALED.

GRAPHIC SCALE

60 0 30 60 120

(IN FEET)

1 inch = 60 ft.

Ø-IRON PIPE FOUND
Ø-IRON ROD FOUND
O-IRON PIPE PLACED

()-RECORDED AS