



PLAT OF SURVEY
-OF-

LOT 2 of CERTIFIED SURVEY MAP No. 1800, as recorded in Volume 8, Page 268 & 269 as Document No. 175891, located in the Southwest 1/4 of Section 3, Township 2 North, Range 18 East in Walworth County, Wisconsin.


Survey For: 1st Banking Center
Survey Location: 6050 Mill St.
Owners: Timm & Joanne Henney

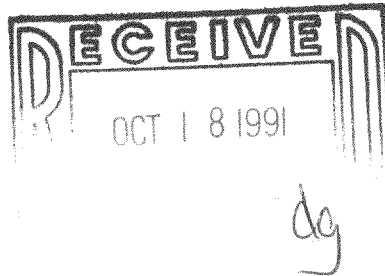

MONUMENTATION BY WRITTEN AGREEMENT
WITH THE ABOVE NAMED CLIENT HAS BEEN
WAIVED IN ACCORDANCE WITH AE 7.01(2)
OF THE ADMINISTRATIVE CODE.

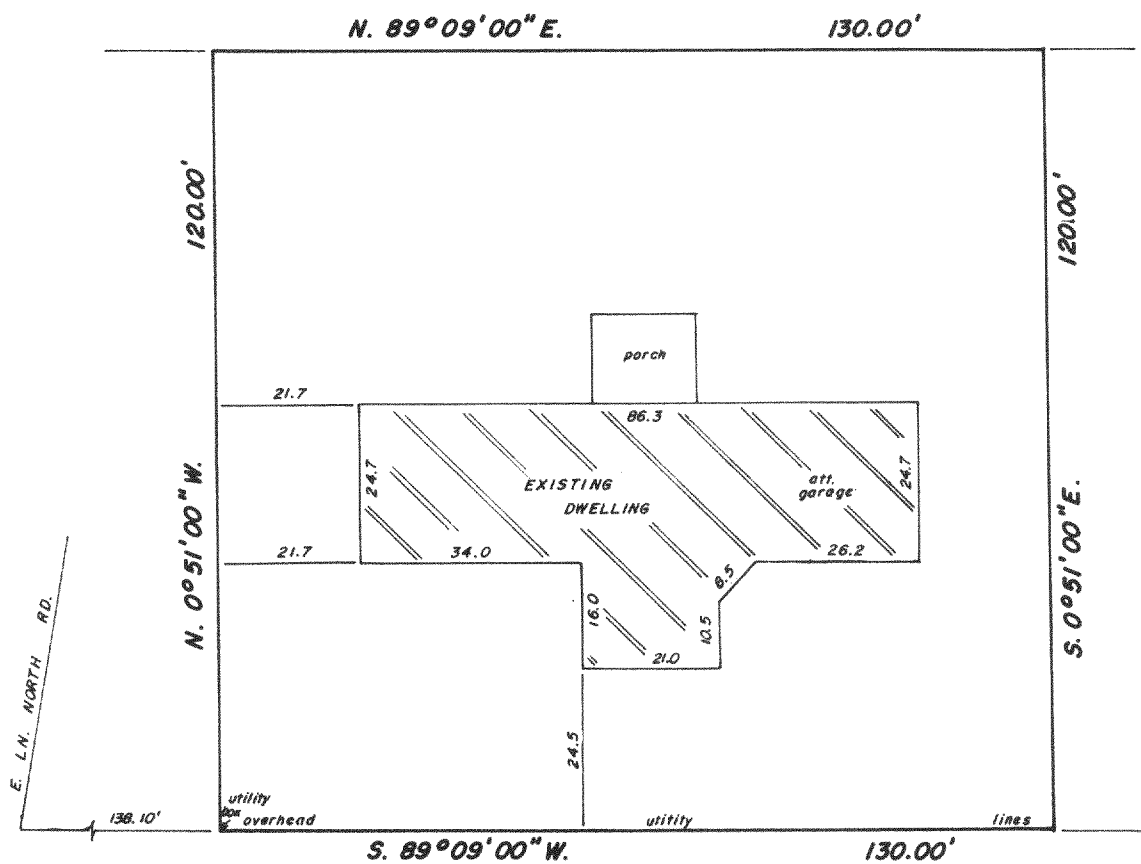


MILL 66' WIDE ST.

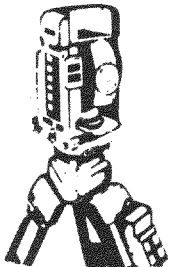

B.W. SURVEYING

Land Surveys
Mapping And Planning
35117 Academy Road
Burlington, Wisconsin 53105
(414) 534-4109

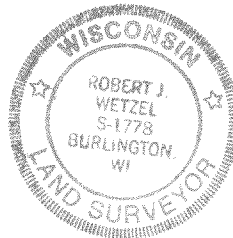

"I hereby certify that I have surveyed the above described property and that the above map is a true representation thereof and shows the size and location of the property, its exterior boundaries, the location of all visible structures and dimensions of all principal buildings thereon, boundary fences, apparent easements, roadways and encroachments, if any.

"This survey is made for the use of the present owners of the property, and those who purchase, mortgage, or guarantee the title thereto within one year from date hereof"

THIS IS NOT AN ORIGINAL PRINT
UNLESS THIS SEAL IS RED

Robert J. Wetzel

ROBERT J. WETZEL
REGISTERED LAND SURVEYOR - 1778

AUG. 1, 1991
DATE

657
JOB NUMBER

218-527

NA 18000000 2