

PLAT OF SURVEY
OF

THE SOUTH HALF OF LOTS 7 & 8, BLOCK 7 OF BURK AND CAMPBELL'S VILLAGE OF LYONS, A SUBDIVISION LOCATED IN THE NORTHWEST 1/4 OF SECTION 10, T. 2 N., R. 18 E. OF THE 4TH P.M., TOWNSHIP OF LYONS, COUNTY OF WALWORTH, STATE OF WISCONSIN.

FOR: ST. JOSEPH'S CHURCH

SCALE 1" = 40'

O = IRON PIPE STAKE SET.

σ = IRON PIPE STAKE FOUND

 = IRON ROD SET


\times = SOLID IRON FOUND.

I have surveyed the above-described property, and the map hereon is a true representation thereof and shows the size and location of the property, its exterior boundaries, the location and dimensions of all visible structures thereon, fences, apparent easements and roadways and visible encroachments, if any.

This survey is made for the exclusive use of the present owners of the property, and also those who purchase, mortgage, or guarantee the title thereto, within one year from date hereof.

Dated at Burlington, this 27th day
of DECEMBER, 1980

John F Degen
John F. Degen, Land Surveyor S 242
589 N. Pine St. Burlington, WI 53105

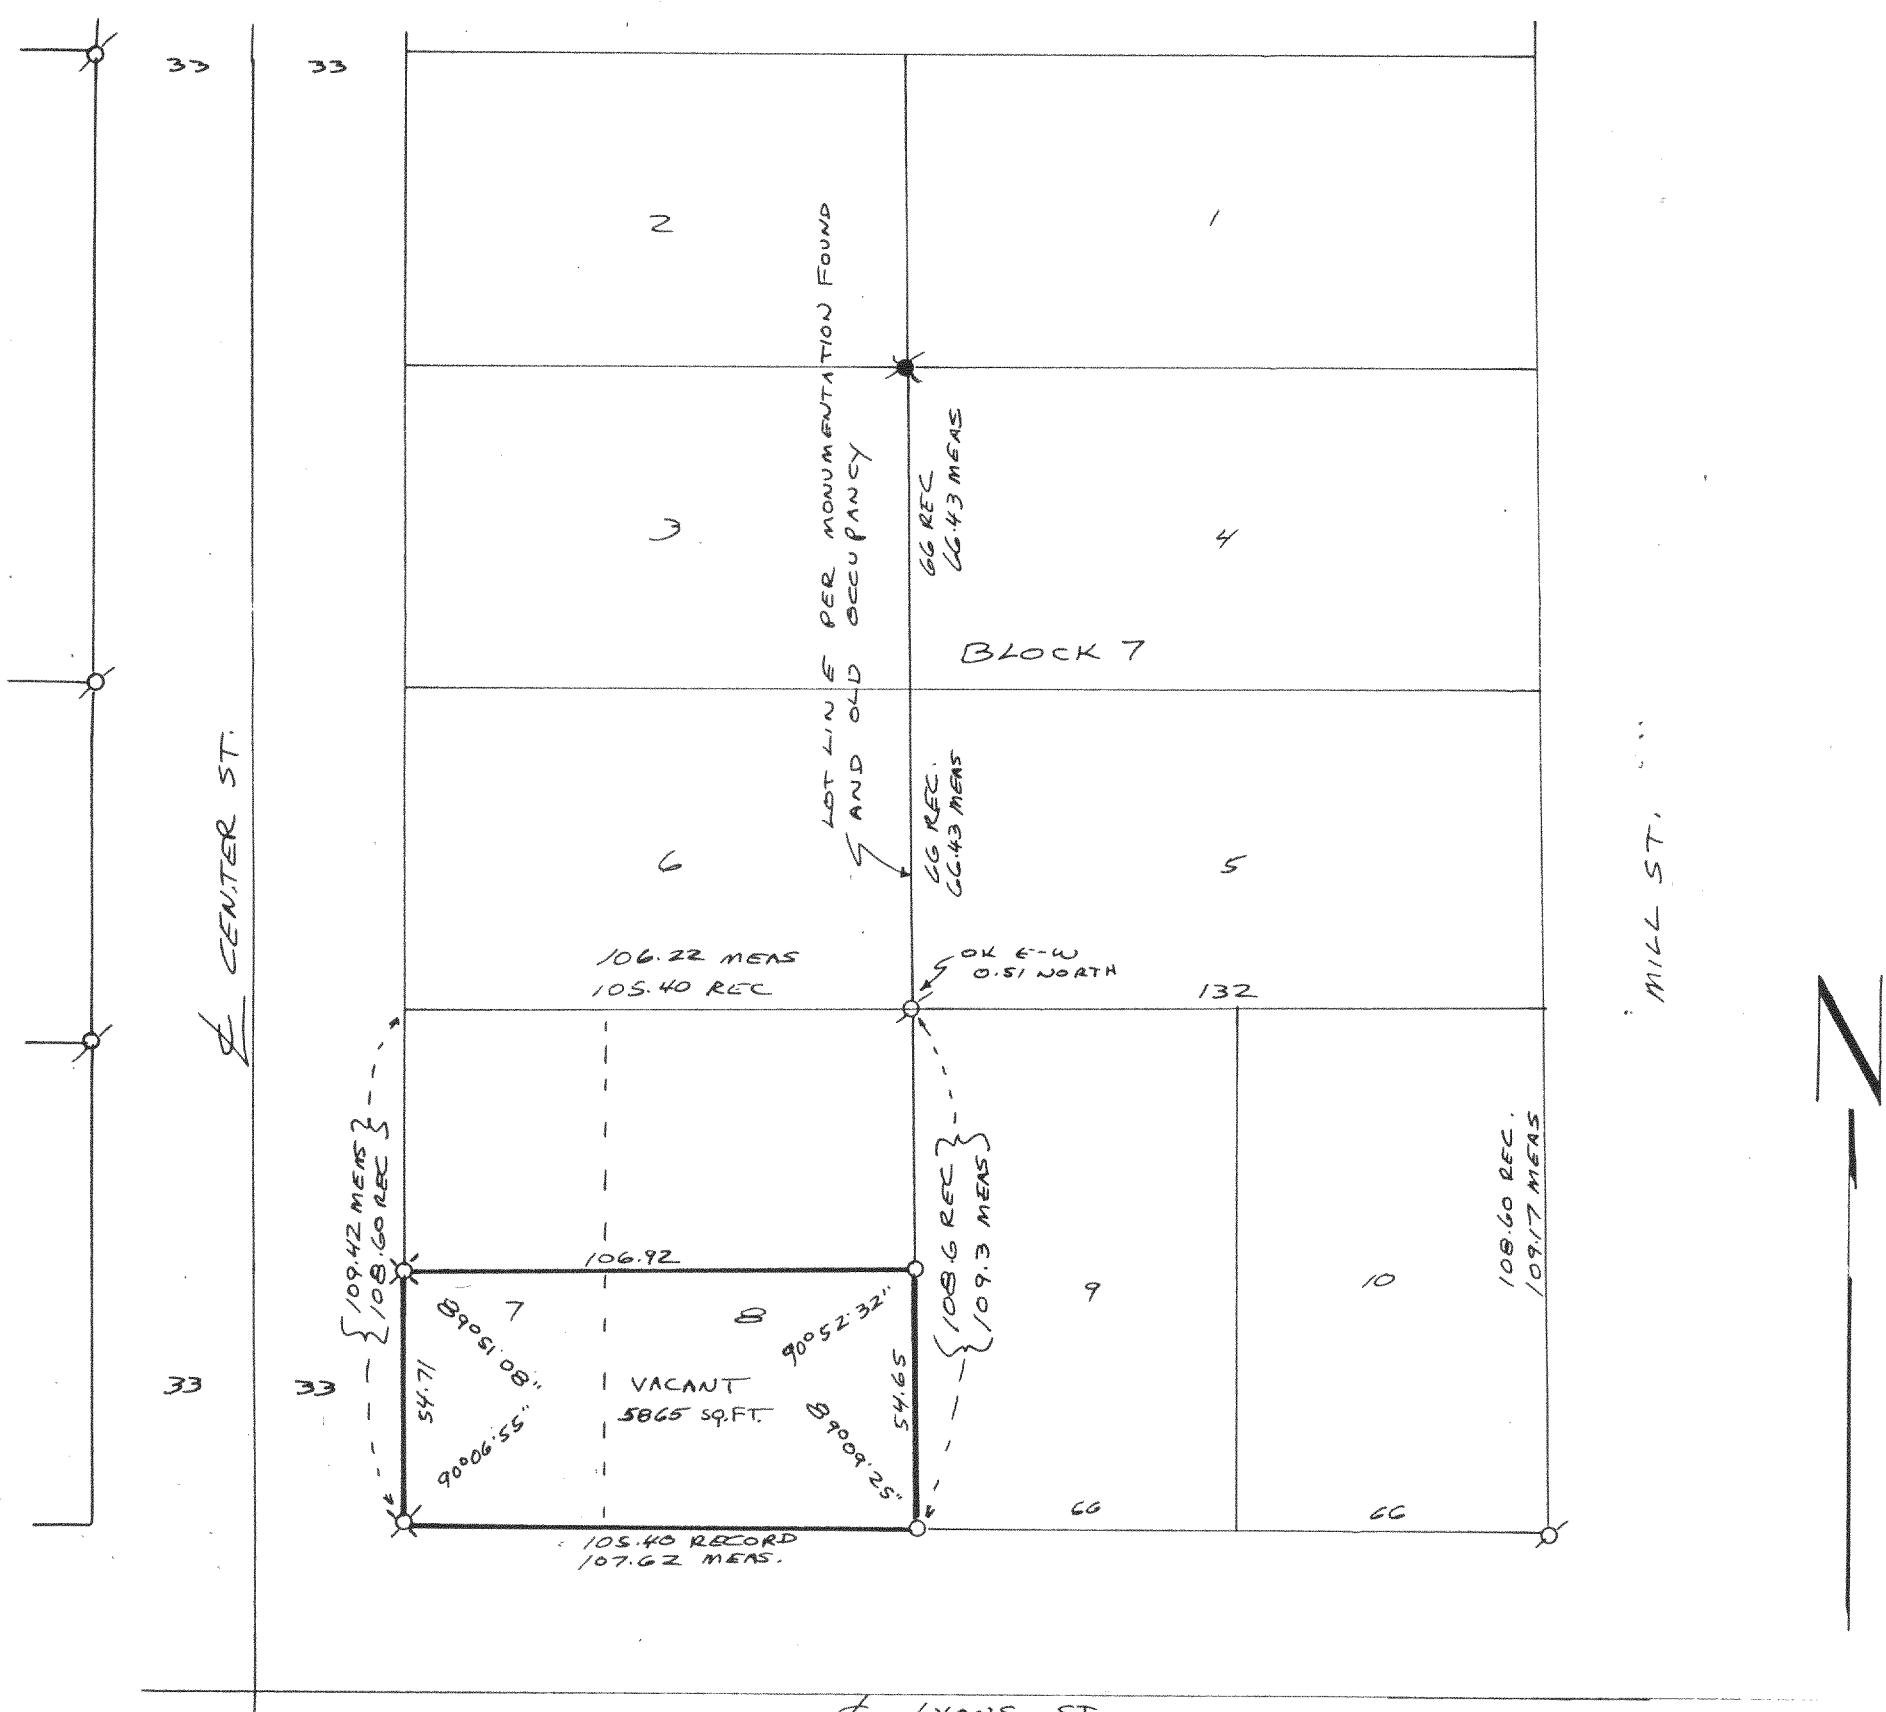

1-03-81

218-558

NL 00052