



ABELL
SURVEYING & MAPPING
DELAVER, WISCONSIN 53115
414-728-6737

SHEET 2 OF 2 SHEETS

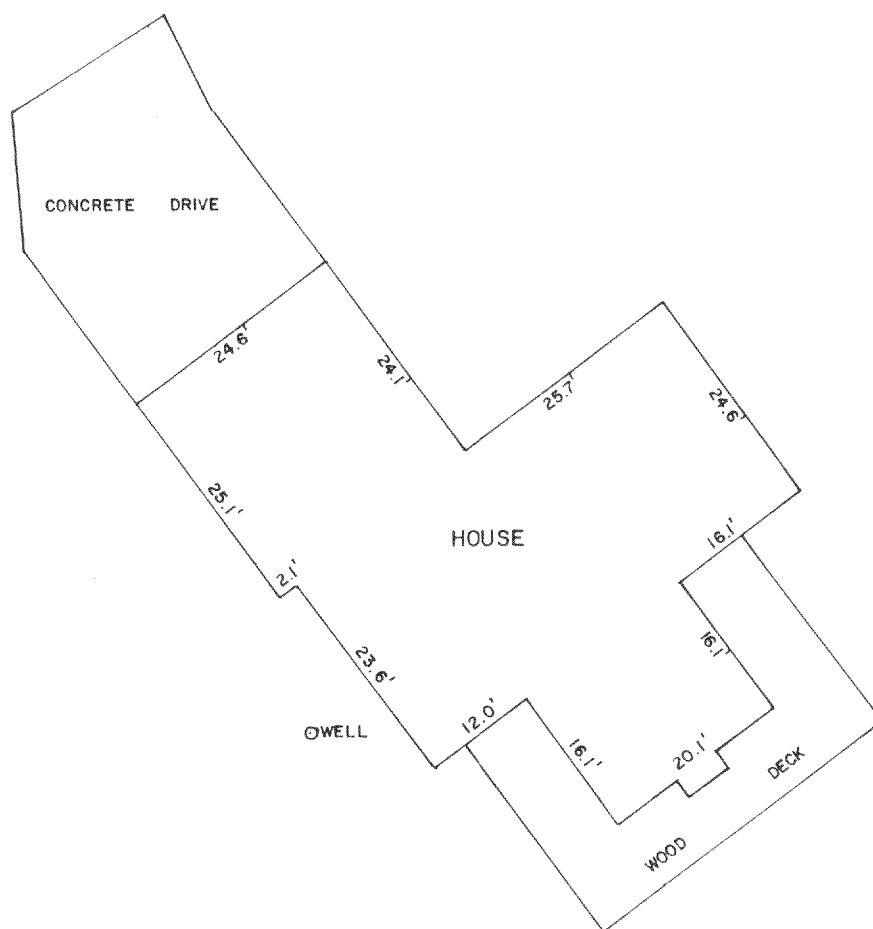

SCALE - 1"=20'

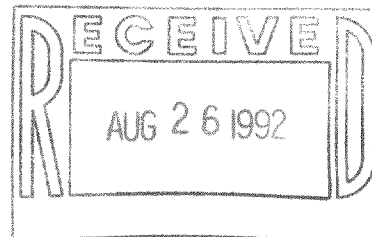

David F. Abell
DAVID F. ABELL
WISCONSIN REGISTERED LAND SURVEYOR, S-1596

May 7, 1992
DATE JOB NUMBER - 88153
NOTE: THIS IS NOT A CERTIFIED COPY UNLESS SEALED.