

727 HENRY STREET
LAKE GENEVA, WISCONSIN
414-248-0505



LOT 47 AND THE N. 1/2 OF LOT 48 OF LAKE GENEVA GOLF HILLS
SUBDIVISION ACCORDING TO THE PLAT THEREOF OF RECORD IN THE
OFFICE OF THE REGISTER OF DEEDS IN AND FOR THE COUNTY OF
WALWORTH AND STATE OF WISCONSIN.

ALSO: BEGINNING AT THE NORTHEAST CORNER OF LOT 75, THENCE SOUTH 75 FEET ON THE EAST BOUNDARY LINE OF LOT 75; THENCE WEST PARALLEL WITH THE NORTH BOUNDARY LINE OF LOT 48 TO THE WESTERLY BOUNDARY LINE OF LOT 75; THENCE NORTHERLY ON THE WESTERLY BOUNDARY LINE OF LOT 75 TO THE PLACE OF BEGINNING, ALL IN LAKE GENEVA GOLF HILLS SUBDIVISION, TOWN OF LYONS, WALWORTH COUNTY, WISCONSIN.

ORDERED BY: C-21 ASSURED REALTY
P. O. BOX 367
WILLIAMS BAY, WISCONSIN 53191


I HEREBY CERTIFY THAT I HAVE SURVEYED THE ABOVE DESCRIBED PROPERTY AND THAT THE ABOVE MAP IS A TRUE REPRESENTATION THEREOF AND SHOWS THE SIZE AND LOCATION OF THE PROPERTY, ITS EXTERIOR BOUNDARIES, THE LOCATION OF ALL VISIBLE STRUCTURES AND DIMENSIONS OF ALL PRINCIPAL BUILDINGS THEREON, BOUNDARY FENCES, APPARENT EASEMENTS, ROADWAYS AND VISIBLE ENCROACHMENTS, IF ANY, TO THE BEST OF MY KNOWLEDGE AND BELIEF.

THIS SURVEY IS MADE FOR THE USE OF THE PRESENT OWNERS OF THE PROPERTY AND ALSO THOSE WHO PURCHASE, MORTGAGE OR GUARANTEE THE TITLE THERETO WITHIN ONE (1) YEAR FROM DATE HEREOF.

HEREOF:
Robert M. Baerenwald
 ROBERT M. BAERENWALD
 WISCONSIN REGISTERED LAND SURVEYOR, S-1508

Dec. 9, 1992
DATE JOB NO. 3663

NOTE: THIS IS NOT A CERTIFIED COPY UNLESS SEALED.

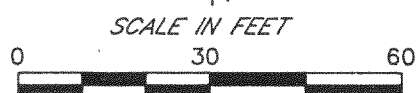

LEGEND

- Ø-IRON PIPE FOUND
 Ø-IRON ROD FOUND
 ●-CONCRETE MONUMENT FOUND
 ○-IRON PIPE PLACED
 ()-RECORDED AS