7 RIDGEWAY COURT, P.O. BOX 437 PLAT OF SURVEY PHONE: (414)723-2098 ELKHORN, WISCONSIN 53121 FAX: (414)723-5886 100 90 80 70 60 90 40 30 20 10 9 MAP SCALE IN FEET P.O.B. 510.28 334.00' LOCATION: Parcel 7 of Unrecorded Park Ridge Subdivision In NE 1/4 NW 1/4 Sec. 28-2-18 Walworth Co., Wi. PARCEL & PAVEMENT AREA 70 OF BACK ROAD 128.80 5.28 ACRES RESIDENCE AS LOCATED 4/07/93 127.30 PARCEL 70 LIMIT OF TITLE OWNERSHIP AT NORTH RIGHT OF WAY OF BACK RD. BORE HOLE THE SOUTH BOUNDARY AND PAUED ON THE WEST. 5.16 ACRES BORG POWER 3 CIGHT CO, EASEMENT DOC,# 320838 DOES NOT DESCRIBE A SPECIFIC ROUTE AND APPEARS TO AFFECT ALL OF THERE ARE NO VISIBLE UTILITIES ON PARCEL T. NORTH RIGHT OF WAY BACK ROAD BY OTHERS N89°51'42"W 18.20-393.76 14.85 OUERH PAUEMENT VIRES ON 5/07/92 PETER S.
GORDON
S-2101
"YORN, Lot 1 POLES ALONG CSM 1335 49.5' WIDE RIGHT OF WAY FOR BIR OF SHOWN ON SURVEYS ARAD FOR 0. L. 34 CSM 1220 PROJECT NO. 3 DATED: 5/07 WI SURVEYUM WPR-7 REVISED TO SHOW RESIDENCE AS BUILT

218-657

APR 4 8 1993

FARRIS, HANSEN & ASSOCIATES, INC.

7 RIDGEWAY COURT, P.O. BOX 437 ELKHORN, WISCONSIN 53121


PHONE:

(414)723-2098

FAX:

(414)723-5886

PROTRACTED LOTS LOCATED IN THE SOUTHWEST 1/4 OF SECTION 21 AND IN THE NORTHWEST 1/4 OF SECTION 28, TOWN 2 NORTH, RANGE 18 EAST WALWORTH COUNTY, WISCONSIN

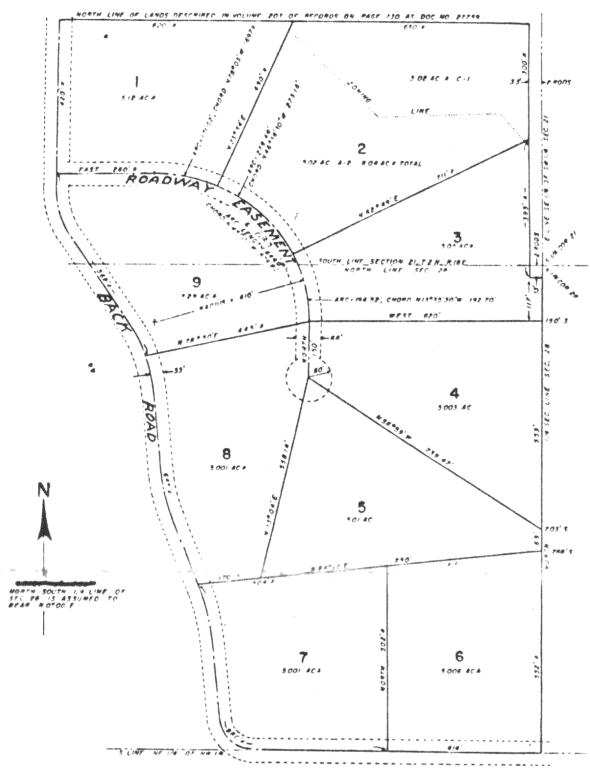

COPY OF UNRECORDED SUBDIVISION PARK

DESCRIPTION LEGAL PARCEL ORDERED

PARCEL NO. 7

NOTE: COPIES OF THIS MAP TO WHICH THE FOLLOWING CERTIFICATE WILL APPLY ARE BLUE LINE PRINTS SHOWING SURVEYOR'S ORIGINAL SEAL AND SIGNATURE IN BLACK INK. COPIES BY ANY OTHER MEANS MAY HAVE ALTERATIONS WHICH DO NOT REPRESENT THE SURVEYOR'S WORK PRODUCT.

Part of the Northeast 1/4 of the Northwest 1/4 of Section 28, Town 2 North, Range 18 East, Walworth County being described as follows: Commencing at the North 1/4 Section croner of said Section 28; thence South 768 feet along the 1/4 Section line; thence S 84°12'W 416 feet to the point of beginning; thence South 502 feet more or less to the South line of said Northeast 1/4 of the Northwest 1/4; thence Westerly along said South line and Northerly along the centerline of Back Road a total of 880 feet more or less to a point located S 84°12'W from the point of beginning; thence N 84°12'E 504 feet more or less to the point of beginning containing 5.001

acres of land more or less.

SURV SURV I HEREBY CERTIFY THAT THE ABOVE DESCRIBED PROPERTY HAS BEEN SURVEYED UNDER MY DIRECTION AND THAT THE ABOVE MAP IS A TRUE REPRESENTATION THEREOF AND SHOWS THE SIZE AND LOCATION OF THE PROPERTY, ITS EXTERIOR BOUNDARIES, THE LOCATION OF ALL VISIBLE STRUCTURES AND DIMENSIONS OF ALL PRINCIPAL BUILDINGS THEREON, BOUNDARY FENCES, APPARENT EASEMENTS, POADWAYS AND VISIBLE ENCROACHMENTS, IF ANY. THIS SURVEY IS MADE FOR THE USE OF THE PRESENT OWNERS OF THE PROPERTY, AND ALSO THOSE WHO PURCHASE, MORTGAGE, OR GUARANTEE THE TITLE THERETO WITHIN ONE YEAR FROM THE DATE HEREOF.

SHOW RESIDENCE AS BUILT

TERS.