ABERNATHY and ASSOCIATES

Kenneth B. Abernathy Jr.

Wisconsin Registered Land Surveyor S-1594


Rt. 3, Box 273 Elkhorn, Wisconsin 53121 Phone: (414) 723-4260 (office) (414) 723-4813 (residence)

## PLAT OF SURVEY

Lot 36 of Clear View Estates Subdivision, located in the Northeast 1/4 of Section 33, Town 2 North, Range 18 East, Town of Lyons, County of Walworth, State of Wisconsin.

## 2nd Avenue

66' Wide

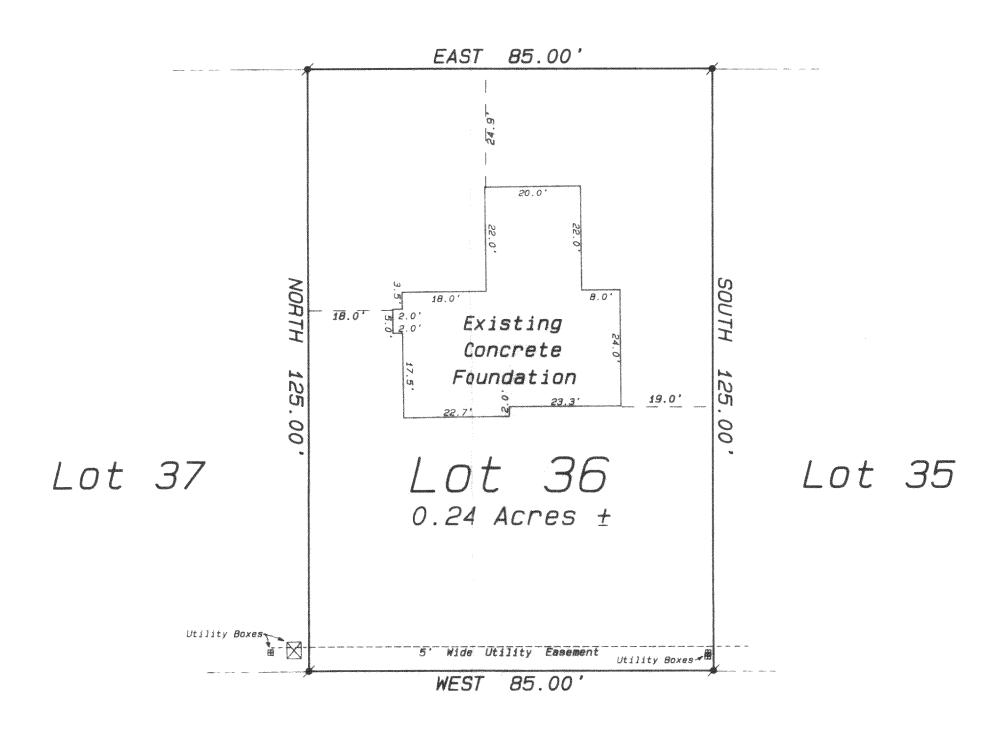

Ordered by: Schauder Building, Inc.
4115 Highway 51 North
Janesville, Wisconsin
53545-9674



### Legend

FOUND IRON PIPE
FOUND IRON ROD

FOUND CONCRETE MONUMENTCHISEL CUT IN CONCRETE

SET IRON ROD, 24<sup>11</sup> LONG, WEIGHING 1.5 LBS./LINEAL FT., 3/4<sup>11</sup> DIA.

FOUND BRASS CAPPED MONUMENT


SET IRON ROD, 30" LONG, WEIGHING

4.5 LBS./LINEAL FT., 1-11/16" DIA.

(xx) RECORDED AS DIMENSION

EXISTING FENCE

KEMMETH B. A
ABERNATHY JR.
S 1594
BAHORN

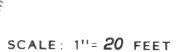

"I hereby certify that I have surveyed the above described property and that the above map is a true representation thereof and shows the size and location of the property, its exterior boundaries, the location of all visible structures and dimensions of all principal buildings thereon, boundary fences, apparent easements, roadways and visible encroachments, if any."

"This survey is made for the use of the present owners of

"This survey is made for the use of the present owners of the property, and also those who purchase, mortgage, of guarantee the title thereto within one year from date hereo."

KENNETH B. ABERNATHY, JR.
WISCONSIN REGISTERED LAND SURVEYOR,

Revised November 11, 1993

Date: October 20, 1993

\_\_ Job No. 1993.1012

ABERNATHY and ASSOCIATES Kenneth B. Abernathy Jr.

Wisconsin Registered Land Surveyor S-1594

Rt. 3, Box 273


Elkhorn, Wisconsin 53121 Phone: (414) 723-4260 (office) (414) 723-4813 (residence)

### PLAT OF SURVEY


Lot 36 of Clear View Estates Subdivision, located in the Northeast 1/4 of Section 33, Town 2 North, Range 18 East, Town of Lyons, County of Walworth, State of Wisconsin.

# 2nd Avenue

66' Wide

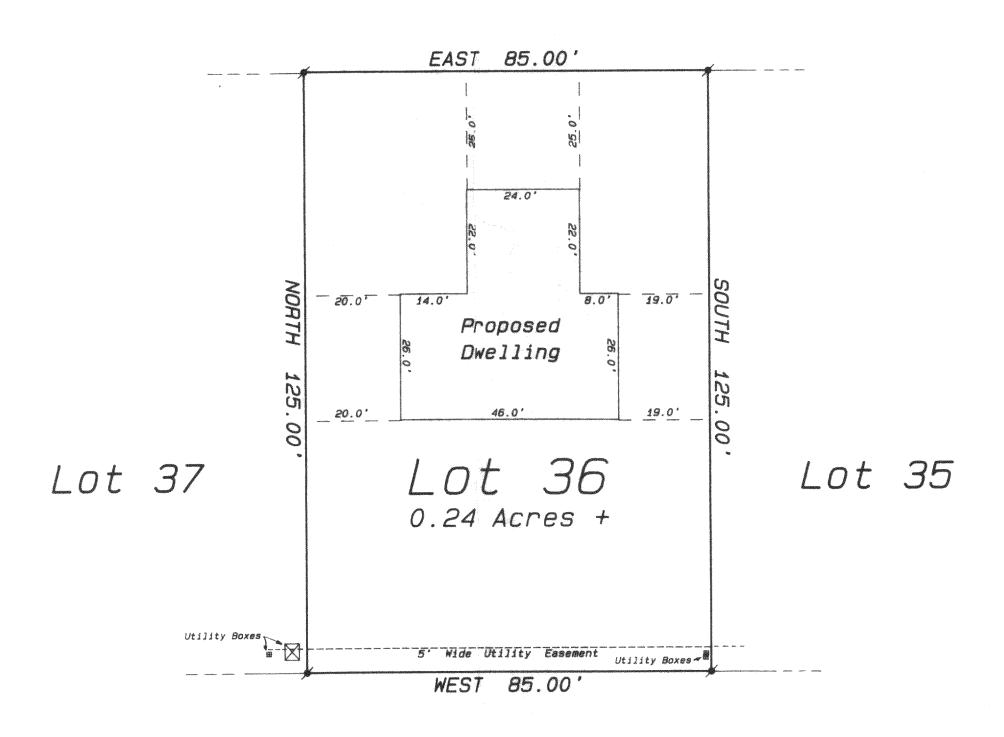

Ordered by: Schauder Building, Inc. 4115 Highway 51 North Janesville, Wisconsin 53545-9674

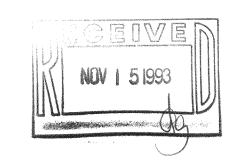


#### Legend

- FOUND IRON PIPE FOUND IRON ROD
- FOUND BRASS CAPPED MONUMENT

- 1.5 LBS./LINEAL FT., 3/4" DIA.
- SET IRON ROD, 30" LONG, WEIGHING 4.5 LBS./LINEAL FT., 1-11/16" DIA.
- (xx) RECORDED AS DIMENSION

-X-X- EXISTING FENCE



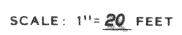

"I hereby certify that I have surveyed the above described property and that the above map is a true representation thereof and shows the size and location of the property, its exterior boundaries, the location of all visible structures and dimensions of all principal buildings thereon, boundary fences, apparent easements, roadways and visible encroach-

ments, if any."
"This survey is made for the use of the present owners of the property, and also those who purchase, mortgage, or guarantee the title thereto within one year from dates

KENNETH B. ABERNATHY, JR. WISCONSIN REGISTERED LAND SURVEYOR

Date: October 20, 1993 Job No. 1993.1012